IREDELL COUNTY HEALTH DEPARTMENT

STATESVILLE 704-878-5305 MOORESVILLE 704-664-5281 (C1)

IMPROVEMENT PERMIT / AUTHORIZATION TO CONSTRUCT / OPERATION PERMIT / EXISTING SYSTEM INSPECTION

PERMIT# 106332 PIN# 4842-17-7505 DATE 5-23-02

OWNER OR CONTRACTOR CHAD & THERESA JULIAN PHONE Business _____ Home 704-539-5553

ADDRESS 204 BUZZARD LANE, OLIN, NC 28660

LOCATION US 21 N, TL JENNINGS RD, TL EUPEPTIC SPRINGS, TR GURNEY, TR BUZZARD RD, TR AT END, on (L)

SUBDIVISION _____ BLOCK / SECTION _____ LOT _____ LOT AREA 1.65 ACRES SITE CLASS PS1 DESIGN FLOW 360 L.T.A.R. EXISTING

Septic Tank: 1000 Gallons: STB _____ Date _____

Pump Tank: _____ Gallons: PT _____ Date _____

Pump Make: _____ Model _____ Serial No _____

Nitrification Field: No Fields 1 Square Feet _____ Linear Feet EXISTING

No Lines TWO Trench Width _____ Max Trench Bottom Depth _____ Gravel Depth _____

☐ New System ☐ Repair System Type: I (II) III IV V VI

System Description: CONVENTIONAL GRAVITY

Repair System Description: CONV. GRAVITY

Maintenance Agreement Required: ☐ Yes ☒ No

☐ Slab ☐ Crawl Space ☐ Basement w/plumbing ☐ Basement wo/plumbing

☐ House/Mod. Home No. Bedrooms 3

☒ Mobile Home No. Bathrooms 2

☐ Business No. Employees _____

☐ Other _____


Water Supply:
☒ Individual
☐ Public
☐ Community
WELL

Comments/Conditions:

Comments/Conditions: SYSTEM UNDERSIZED ACCORDING TO TODAY'S STANDARDS.

INITIAL SITE SKETCH

AS BUILT SKETCH

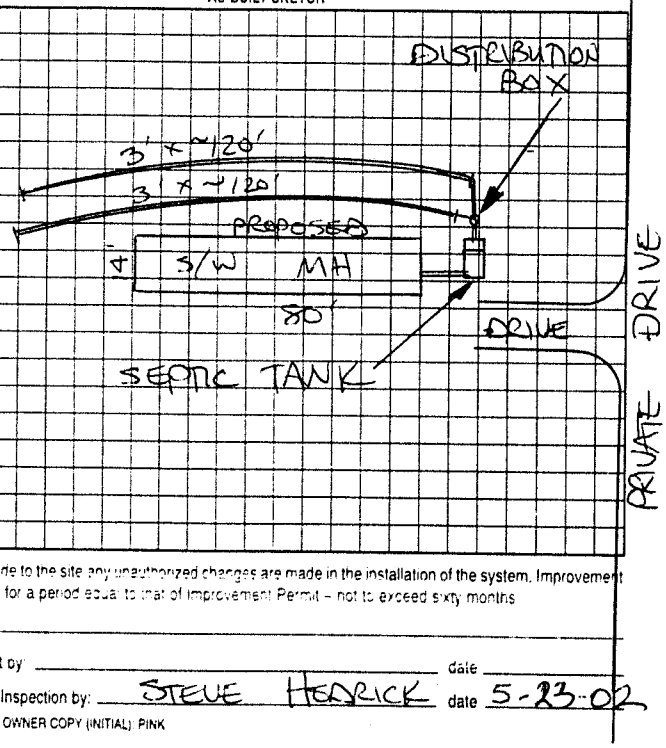

Permit can be suspended or revoked if any false information is supplied toward securing the permit/any unauthorized changes are made to the site any unauthorized changes are made in the installation of the system. Improvement Permit with plat valid without expiration. Improvement Permit with site plan valid for sixty months. Authorization to Construct is valid for a period equal to that of Improvement Permit – not to exceed sixty months.

Signed: _____ date _____ Installed by _____

Improvement Permit by: _____ date _____ Operation Permit by _____ date _____

Authorization to Construct by: _____ date _____ Existing System Inspection by: STEVE HEDRICK date 5-23-02

HEALTH DEPT. COPY: WHITE OWNER COPY (FINAL): YELLOW OWNER COPY (INITIAL): PINK