DELL COUNTY HEALTH DEPARTMENT

Statesville Office (704) 878-5305 Mooresville Office (704) 660-3625

IMPROVEMENT PERMIT / AUTHORIZATION TO CONSTRUCT / OPERATION PERMIT / EXISTING SYSTEM

PERMIT # 213585

APPLICANT: Billy Joe Thorpe

APPLICANT ADDRESS: 1505 Pendergrass Rd.

PIN # 4842209534

SITE ADDRESS: 227 Trumpet Branch Rd.

PHONE: 910-824-1645 ALT. PHONE: N/A

SITE DIRECTIONS: Hwy 21 N TL Jennings TL Trumpet Branch Rd. Property on Left. behind 225 Trumpet Branch Rd.

SUBDIVISION: N/A


SECTION: N/A LOT # N/A LOT AREA: 1.11 acres DESIGN FLOW: 360gpd L.T.A.R.: 0.275

Septic Tank	1000 (gal)	STB	1012-1000	Date	4-13-15	☑ New System ☐ Repair ☐ Expansion	System Type: I II III IV V VI	☑ Residence	No. Bedrooms 3
Pump Tank	(gal)	PT		Date		System Description:	25% Reduction	☐ Business	No. Persons 6
Pump Make		Model		Serial #		Repair System Description:	25% Reduction - shallow	☐ Other	No. Employees
# Nitrification Fields	1	# Lines	5	Linear Ft:	330	Maintenance Agreement Required:	☐ YES ☑ NO	☐ Slab	☑ Crawl Space
Trench Width	36"	Max. Trench Bottom Depth	30"	Gravel Depth	N/A	☑ GRAVITY	☐ PRESSURE	☐ Basement w/plumbing	☐ Basement w/o plumbing

Water Supply: ☑ Private ☐ Public ☐ Community

Comments / Conditions: Install a 25% Reduction system on contour with serial distribution. Fill in existing stump hole @ location shown below 66

INITIAL SITE SKETCH

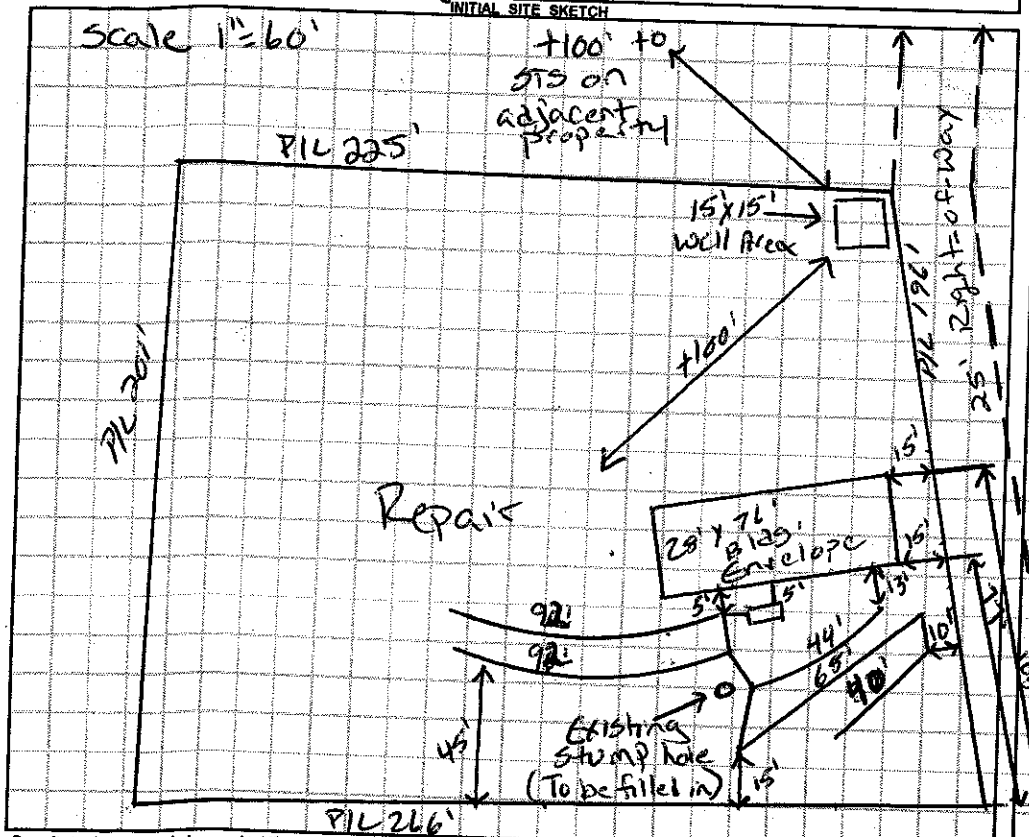

AS BUILT SKETCH

- Yellow Tuf-Tite Filter installed
- 2" PVC ST marker installed
- Quick 4 Chamber installed
- Installed as Drawn

Permit can be suspended or revoked if any false information is supplied toward securing the permit / any unauthorized changes are made to the site / any unauthorized changes are made in the installation of the system. CONTACT A LOCATOR SERVICE PRIOR TO ANY EXCAVATION

☐ IMPROVEMENT PERMIT *with plat* valid without expiration. ☑ IMPROVEMENT PERMIT *with site plan* valid for 60 mos. ☑ AUTHORIZATION TO CONSTRUCT valid for period equal to IMPROVEMENT PERMIT--not to exceed 60 mo.

Owner / Applicant Signature: [signature] Date: 9-1-15

IMPROVEMENT PERMIT by: Justin Henderson Date: 9-1-15

AUTHORIZATION TO CONSTRUCT by: Justin Henderson Date: 9-1-15

Installed by: Steve Jordan

OPERATION PERMIT by: Justin Henderson Date: 12-16-15

Existing System Inspected by: Date:

Health Dept. Copy - WHITE Applicant (Final Approval) - YELLOW Applicant (Conditional Approval) - PINK