William & Gloria Smith property

IREDELL COUNTY HEALTH DEPARTMENT

STATESVILLE 704-878-5305 CI MOORESVILLE 704-664-5281

IMPROVEMENT PERMIT / AUTHORIZATION TO CONSTRUCT / OPERATION PERMIT / EXISTING SYSTEM INSPECTION

PERMIT# 131687 PIN# 4842 26 6370 58778 DATE 11-7-05

OWNER OR CONTRACTOR William C & Gloria J Smith PHONE: Business Home 704 309 1294

ADDRESS 1079 Eupeptic Springs Rd

LOCATION Jennings Rd N- (R) on Eupeptic Springs - Property on (R)

SUBDIVISION ~~nat williams~~ BLOCK / SECTION LOT 2 LOT AREA 22.166 SITE CLASS PS DESIGN FLOW 360 L.T.A.R. .3

Septic Tank: 1000 Gallons; STB 825 Date 11-07-05

Pump Tank: Gallons; PT Date

Pump Make: Model Serial No.

Nitrification Field: No Fields 1 Square Feet 1200 Linear Feet 300

No Lines 4 Trench Width 3 Max Trench Bottom Depth 36 Gravel Depth n/a

☒ New System ☐ Repair System Type: I, (II), III, IV, V, VI

System Description: 25% Reduction - Gravity

Repair System Description: 25% Reduction/Pump

Maintenance Agreement Required: ☐ Yes ☐ No

☐ House/Mod. Home ☒ Mobile Home ☐ Business ☐ Other

No. Bedrooms 3 No. Bathrooms No. Employees


☐ Slab ☒ Crawl Space ☐ Basement w/plumbing ☐ Basement wo/plumbing

Water Supply: ☐ Individual ☒ Public ☐ Community


Comments:/Conditions:

Comments:/Conditions: TUFF TITE Fitt & MARKER

INITIAL SITE SKETCH

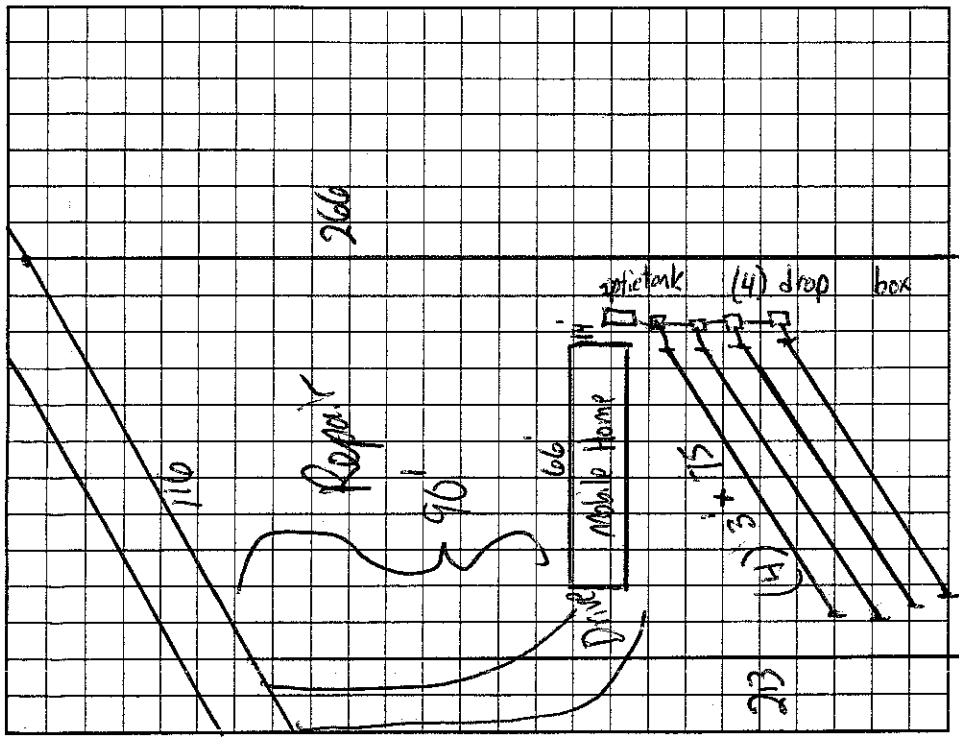

AS BUILT SKETCH

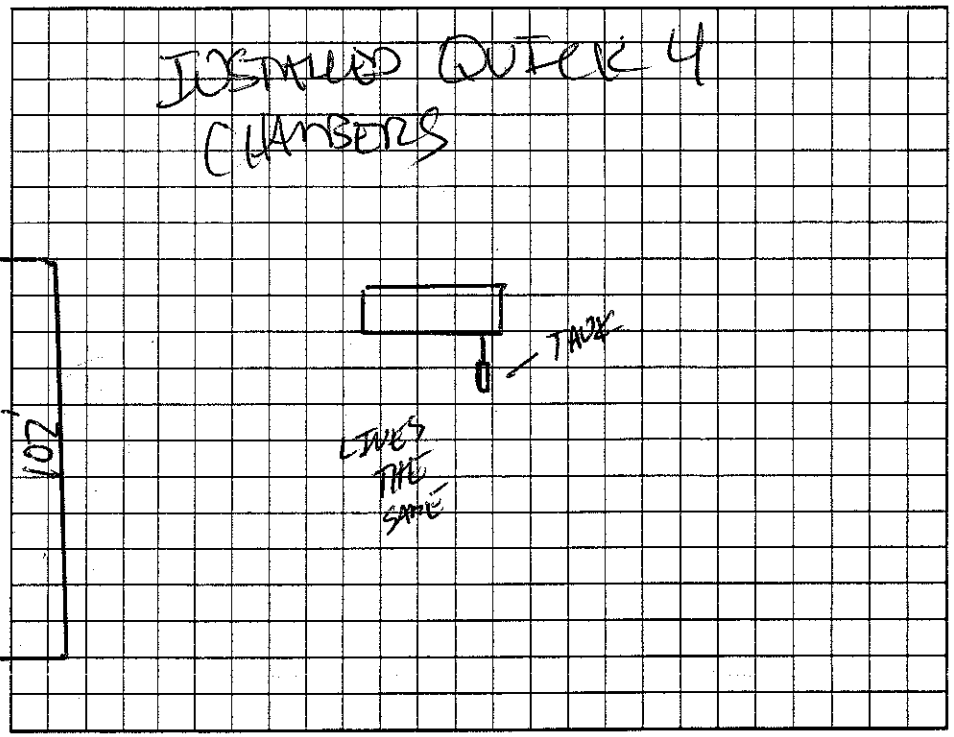

Permit can be suspended or revoked if any false information is supplied toward securing the permit/any unauthorized changes are made to the site/any unauthorized changes are made in the installation of the system. Improvement Permit with plat valid without expiration. Improvement Permit with site plan valid for sixty months. Authorization to Construct is valid for a period equal to that of Improvement Permit – not to exceed sixty months.

Signed: William C Smith date

Improvement Permit by: James Stewart date 11-7-05

Authorization to Construct by: James Stewart date 11-7-05

Installed by: MADISON GRADING

Operation Permit by: [signature] date 12-28-05

Existing System Inspection by: date

HEALTH DEPT. COPY: WHITE OWNER COPY (FINAL): YELLOW OWNER COPY (INITIAL): PINK