IREDELL COUNTY HEALTH DEPARTMENT

STATESVILLE 704-878-5305 (2) MOORESVILLE 704-664-5281

IMPROVEMENT PERMIT / AUTHORIZATION TO CONSTRUCT / OPERATION PERMIT / EXISTING SYSTEM INSPECTION

PERMIT# 108221 PIN# 4842-26-6375 DATE 9-11-02

OWNER OR CONTRACTOR FLEETWOOD HOMES OF STATESVILLE PHONE: Business 704-872-0179 Home

ADDRESS 1270 NORTHSIDE DRIVE, STATESVILLE NC 28625

LOCATION US 21 N, TL JENNINGS RD, TL EUPEPTIC SPRINGS ROAD, 0.2 MILE ON RIGHT, 200' BACK

SUBDIVISION BLOCK / SECTION LOT LOT AREA 1.0 ACRE SITE CLASS PS DESIGN FLOW 480 L.T.A.R. 0.30 GPD/FT²

Septic Tank: 1000 Gallons; STB 1012 Date 4-9-02
Pump Tank: Gallons; PT Date
Pump Make: Model Serial No.
Nitrification Field: No Fields 1 Square Feet EQ. TO 1600 Linear Feet 400
No Lines FIVE Trench Width 36" Max Trench Bottom Depth (28") Gravel Depth N/A

☑ New System ☐ Repair System Type: I. II (III) IV. V. VI
System Description: 25% REDUCTION GRAVITY
Repair System Description: 25% REDUCTION, PUMP
Maintenance Agreement Required: ☐ Yes ☑ No
☐ Slab ☑ Crawl Space ☐ Basement w/plumbing ☐ Basement w/o plumbing


☐ House/Mod Home ☑ Mobile Home ☐ Business ☐ Other
No. Bedrooms 4 No. Bathrooms 2 No Employees

Water Supply: ☐ Individual ☑ Public ☐ Community


Comments/Conditions: ① INSTALL 25% REDUCTION SYSTEM ON CONTOUR AS FLAGGED, NO DEEPER THAN 28"
② NO EXCAVATION ALLOWED BELOW ELEVATION OF FIRST DRAINLINE, PUMP SYSTEM REQUIRED IF THIS CONDITION IS VIOLATED.

Comments/Conditions SEPTIC TANK W/ MARKER INSTALLED USING "TUFTITE" FILTER

INITIAL SITE SKETCH SCALE: 1"=50'

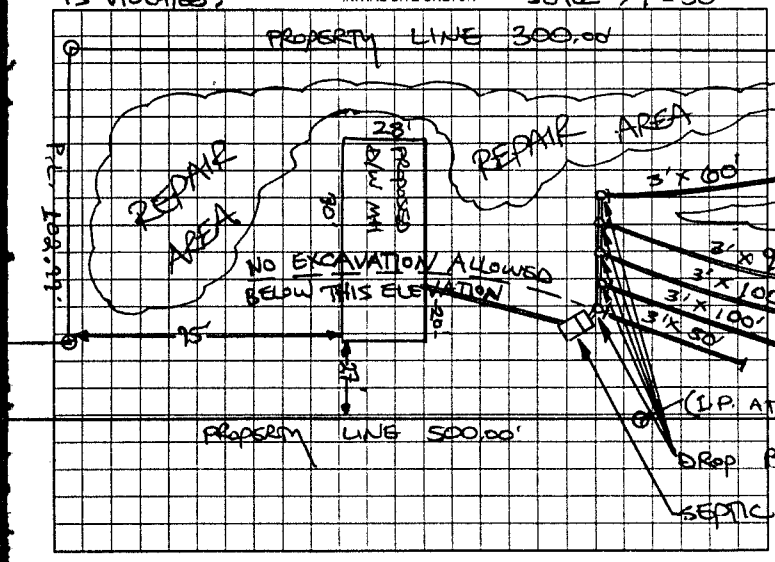

AS BUILT SKETCH

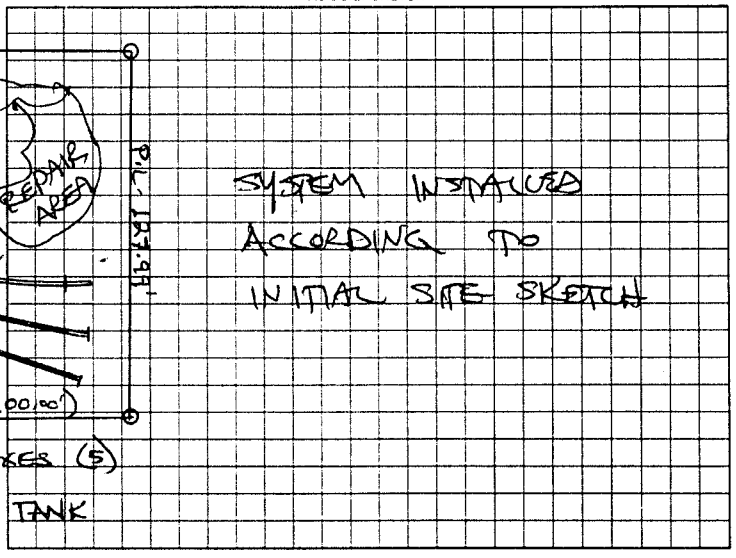

Permit can be suspended or revoked if any false information is supplied toward securing the permit/any unauthorized changes are made to the site any unauthorized changes are made in the installation of the system. Improvement Permit with plot valid without expiration. Improvement Permit with site plan valid for sixty months. Authorization to Construct is valid for a period equal to that of Improvement Permit – not to exceed sixty months.

Signed: date 9/13/02 Installed by CRAIG THOMPSON

Improvement Permit by: STEVE HEDRICK date 9-11-02 Operation Permit by STEVE HEDRICK date 9-19-02

Authorization to Construct by: STEVE HEDRICK date 9-11-02 Existing System Inspection by: date

HEALTH DEPT. COPY: WHITE OWNER COPY (FINAL): YELLOW OWNER COPY (INITIAL): PINK