IREDELL COUNTY HEALTH DEPARTMENT

Statesville Office (704) 878-5305 Mooresville Office (704) 660-3625 PERMIT # 230042

SEPTIC IMPROVEMENT PERMIT / AUTHORIZATION TO CONSTRUCT / OPERATION PERMIT / EXISTING SYSTEM

PIN # 4842306962.

APPLICANT/OWNER: Dennis Gallihar/Natalie Connett APPLICANT ADDRESS: 3360 Jennings RD Statesville NC

SITE ADDRESS: 212 Trumpet Branch. Olin NC 28660. PHONE: 704-902-4615 ALT. PHONE ~

SITE DIRECTIONS: 21N Left on Jennings Left on Trumpet Branch. ½ mile on Right SAP CONTROLLED: ☐ YES ☒ NO

SUBDIVISION: ~ SECTION: ~ LOT # ~ LOT AREA: 5 Acres DESIGN FLOW: 360 gpd L.T.A.R.: Ext


Septic Tank	1000 (gal)	STB	854.	Date	7/5/2017.	☐ New System	☒ Repair	☐ Expansion	System Type: I (II) III IV V VI
Pump Tank	(gal)	PT		Date		System Description:			
Pump Make		Model		Serial #		Repair System Description:	Tank Replacement		
# Nitrification Fields	Ext	# Lines	Ext	Linear Ft	Ext	Maintenance Agreement Required:	☐ YES	☒ NO	
Trench Width	Ext	Trench Bottom Depth(Low side)	Ext	Gravel Depth	Ext		☒ GRAVITY	☐ PRESSURE	

☒ Residence	No. Bedrooms	3	Water Supply
☐ Business	No. Persons	6	☐ Private
☐ Other	No. Employees		☒ Public
☐ Slab	☒ Crawl Space		☐ Community
☐ Basement w/plumbing			☐ Basement w/o plumbing

Comments / Conditions: Crush + Fill or haul existing septic tank. Replace with New Septic tank. Maintain 10 ft min from House Foundation Inspect + Replace D-Box if necessary.

Tank is 18 ft from House ~ D-Box Replaced at time of tank replacement.

INITIAL SITE SKETCH

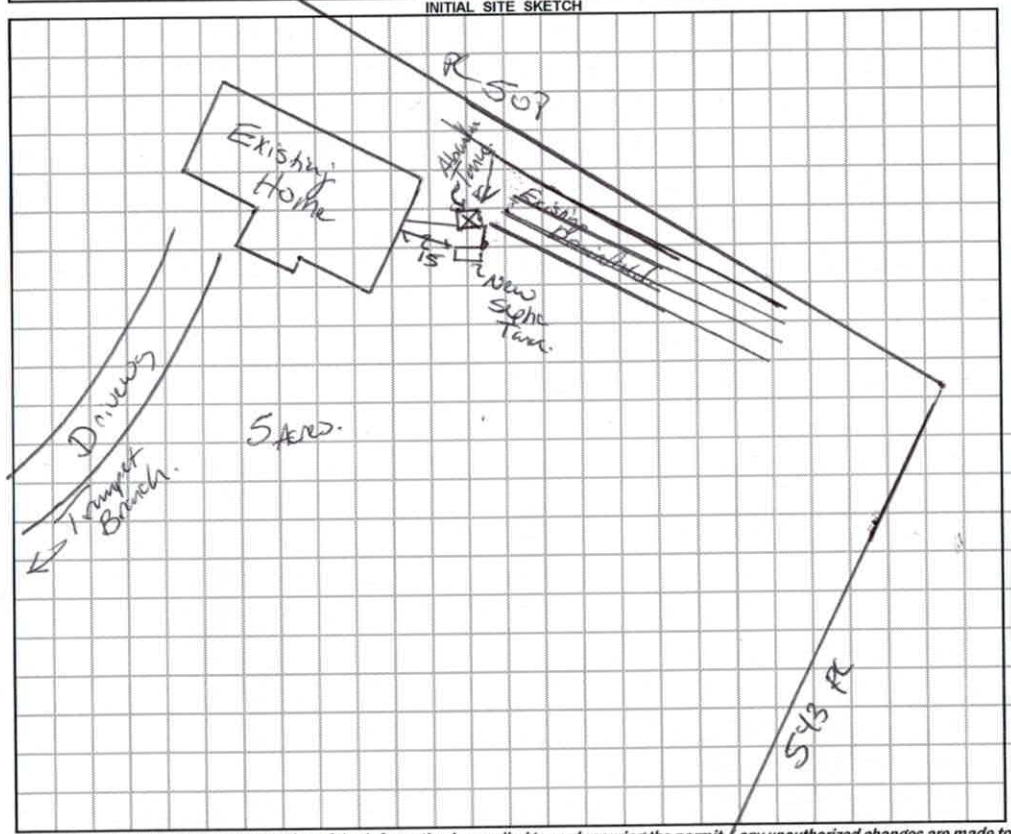

AS BUILT SKETCH

Permit can be suspended or revoked if any false information is supplied toward securing the permit / any unauthorized changes are made to the site / any unauthorized changes are made in the installation of the system. **CONTACT A LOCATOR SERVICE PRIOR TO ANY EXCAVATION**

☐ **IMPROVEMENT PERMIT** *with plat valid without expiration.* ☒ **IMPROVEMENT PERMIT** *with site plan valid for 60 mos.* ☒ **AUTHORIZATION TO CONSTRUCT** *valid for period equal to IMPROVEMENT PERMIT--not to exceed 60 mo.*

Owner / Applicant Signature: Dennis Gallihar Date: 9-14-17 Installed by: Dennis Gallihar

IMPROVEMENT PERMIT by: Benjamin A Botkin Date: 9/13/2017 OPERATION PERMIT by: Benjamin A Botkin Date: Sept 14 201

AUTHORIZATION TO CONSTRUCT by: Benjamin A Botkin Date: 9/13/2017 Existing System Inspected by: Date:

230042

IREDELL COUNTY HEALTH DEPARTMENT *ENVIRONMENTAL HEALTH DIVISION*

12-25-17

(THE ABOVE PERMIT DOCUMENTS WILL BECOME INVALID IF INFORMATION PROVIDED ON THIS APPLICATION IS FALSIFIED OR CHANGED, OR IF THE SITE IS ALTERED. THE IMPROVEMENT PERMIT IS VALID FOR EITHER 60 MONTHS OR WITHOUT EXPIRATION DEPENDING UPON DOCUMENTATION SUBMITTED - APPLICATION WITH SITE PLAN 60 MONTHS, APPLICATION WITH COMPLETE, SCALED PLAT WITHOUT EXPIRATION. SEE 15A NCAC 18A .1937(f) FOR DETAILS) TANK REPLACEMENT

1. APPLICATION FOR: ___Improvement Permit ___Authorization To Construct ___Existing System Inspection

2. Page 2: *Site Plan Worksheet* Form MUST Accompany This Application
   The following optional attachments may also be submitted: ___Survey Plat, Scaled no more than 1 Inch = 60 Feet
   Place check ( ) beside whichever is submitted if applicable ___Custom Site Plan, Scaled no more than 1 Inch = 60 Feet

3. Applicant Information:

Applicant Name	Mailing Address	Home Phone #	Alternate Phone #
Dennis Gallihen	3360 JENNINGS Rd	704 902-4015	
Owner Name	Mailing Address	Home Phone #	Alternate Phone #
Natalie Cornett	Cornett 212 Trumpet Branch		

4. Property Information:

Street Address	Subdivision Name	Section/Phase and Lot Number
212 TRUMPET BRANCH Rd		

Driving Directions: 21 N LEFT ON JENNINGS Rd LEFT ON TRUMPET BRANCH ½ MILE ON RIGHT (212 TRUMPET BRANCH) Olin, NC 28660

5. RESIDENTIAL Site Development Information: *(Check or Complete ALL that apply)*

( ) New, Single Family Residence
( ) New, Multi-Family Residence
( ) Expansion of Existing Septic System
(✓) Repair To Failing Septic System due to TANK REPLACEMENT
( ) Other

Maximum Number of Bedrooms 3
Maximum Number of Occupants ___
If Expansion, Current Number of Bedrooms ___

(✓) Crawl Space Foundation?
( ) Concrete Slab Foundation?
( ) Basement w/Plumbing?
( ) Basement w/out Plumbing?

IF Non-Residential Site Development:
Type of Business
Square Footage of Building
Maximum Number of Employees
Maximum Number of Seats

6. Proposed Water Supply:

( ) New Well ( ) Existing Well ( ) Community Well ( ) City Water ( ) Other Public Water

7. Desired Septic System Type: *(You may rank in order of preference, if any)* ( ) EXISTING SYSTEM installed ____ *Year*

( ) Alternative ( ) Conventional ( ) Innovative ( ) Modified Conventional ( ) Other ____

8. Please Answer The Following To The Best of Your Ability:
   ( ) Yes (✓) No Does the site contain any jurisdictional wetlands?
   ( ) Yes (✓) No Is any non-domestic sewage (i.e. industry) to be generated?
   ( ) Yes (✓) No Is the site subject to approval by any other public agency?

I have read this application and certify that the information provided herein is true, complete, and correct. Authorized county and state officials are granted right of entry to conduct necessary inspections to determine compliance with applicable laws and rules. I understand that I am solely responsible for the proper identification and labeling of all property lines and corners and making the site accessible so that a complete site evaluation can be performed.

9. Signature: Dennis Gallihen — Sept 11 2017
   Property owner or owner's legal representative signature (SIGNATURE REQUIRED) — DATE

IREDELL COUNTY DEPARTMENT OF ENVIRONMENTAL HEALTH

DOCUMENTATION TO AUTHORIZE AN OWNER'S LEGAL REPRESENTATIVE

Applications for permits require the "signature of the owner or owner's legal representative" (15A NCAC 18A .1937). If the owner does not sign the application himself or herself, they can submit any one of the following documents to designate their legal representative:

Power of Attorney; Real Estate Contract; Estate executor; Bankruptcy trustee; Court ordered guardianship

In the absence of the above documentation, the property owner may provide the local health department with documentation that designates a legal representative. A property owner may:

Complete this form to document his or her legal representative, or provide his or her own form that contains the information in this form.

If there are multiple property owners, then all property owners must sign the form that designates a legal representative.

By signing a form that designates a legal representative for purposes of 15A NCAC 18A .1937, the property owner authorizes that representative to act on their behalf in matters pertaining to the application and permitting process, including signing or receiving any application, document or permit. The owner retains full responsibility to meet all permit conditions specified by the local health department.

I, _____, am the legal owner(s) of the property located at _____, identified as PIN (Parcel Identification Number) _____, located in Iredell County, North Carolina.

I do hereby authorize **(print legal representative/company name)** _____, _____, to act as an agent on my behalf in applying for/signing/obtaining any of the documents described below.

- Application for Improvement Permit (IP) / Authorization to Construct (AC)
- Improvement Permit (IP) / Authorization to Construct (AC)
- Application for soil-site evaluation (new/repair)
- Application/permit for private drinking water well/well abandonment
- Application for Compliance Inspection

I agree to abide by all decisions and/or conditions between the legal representative acting on my behalf and the Iredell County Department of Public Health, Environmental Health Division.

Natalee Cornett Sept 12 17 _____ _____

Signature of Owner(s) Date Signature of Witness Date

Please return this signed form to the appropriate office:

Mooresville - Environmental Health
ronda.hart@co.iredell.nc.us
Fax: 704-662-3239
610 E. Center Avenue, Mooresville, NC 28115

Statesville - Environmental Health
adrienne.shea@co.iredell.nc.us
Fax: 704-871-3483
349 N. Center Street, Statesville, NC 28677

IREDELL COUNTY HEALTH DEPARTMENT *ENVIRONMENTAL HEALTH DIVISION*:

SITE PLAN WORKSHEET

SEE THE "SAMPLE SITE PLAN" BELOW. ***INCOMPLETE SITE PLANS WILL BE RETURNED TO YOU FOR COMPLETION AND MAY RESULT IN A DELAY IN THE ISSUANCE OF YOUR SEPTIC SYSTEM PERMIT!!!***

Place an (X) beside each item as you complete the site plan:

_____ Property Line measurements are clearly identified... **_____ All proposed structures are indicated...**

SHOW: proposed house or business footprint, wells, water lines, patios, pools and decks, and any other item that will occupy space on the site


_____ Front and side setbacks from property line... **_____ Preferred driveway location and configuration, preferred well location...**

_____ Area you prefer your septic system to be placed... **_____ North arrow, or other sufficient indicator of direction...**


Circle N/A on the following if appropriate:

_____ Location of septic systems and wells within 100' of your property... N/A

_____ Location of easements and rights of ways on your property... N/A **_____ Location of any designated wetlands on the property... N/A**

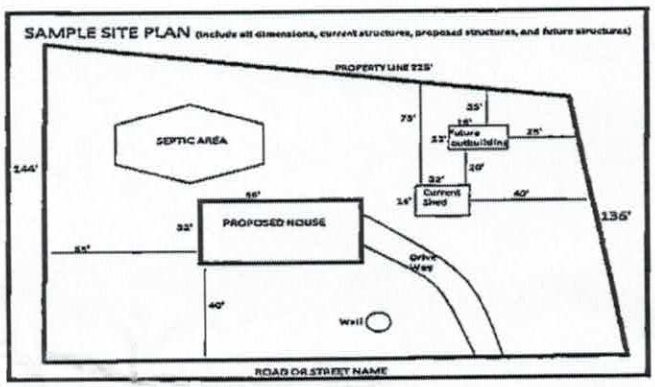

USE THIS SPACE TO DRAW YOUR SITE PLAN

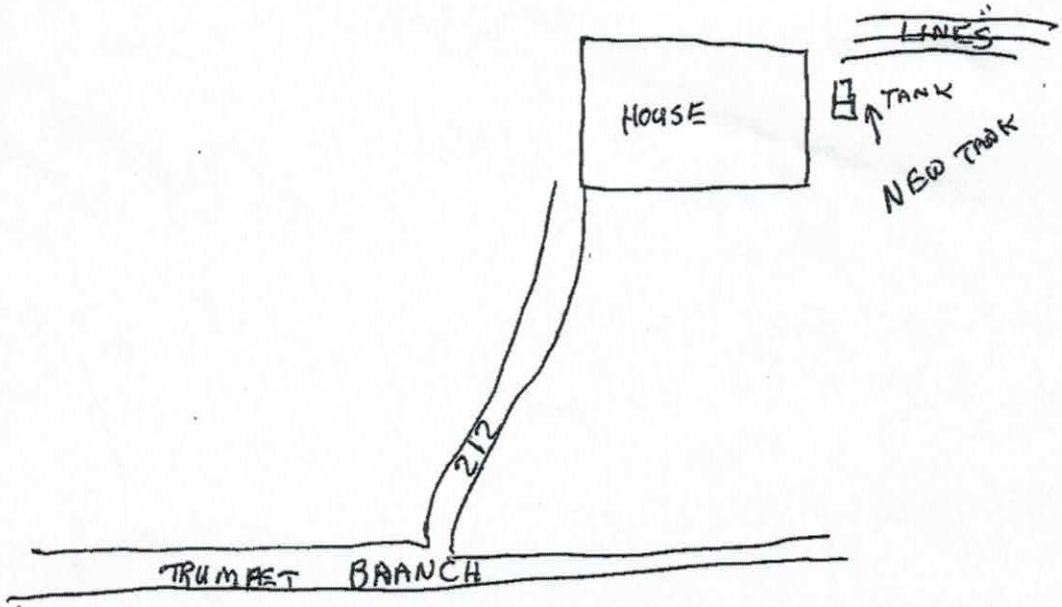

Signature: Natalie Comett

REQUIRED property owner or owner's legal representative signature.

9-12-2017

DATE