IREDELL COUNTY HEALTH DEPARTMENT

STATESVILLE 704-878-5305 CI MOORESVILLE 704-664-5281

IMPROVEMENT PERMIT / AUTHORIZATION TO CONSTRUCT / OPERATION PERMIT / EXISTING SYSTEM INSPECTION

PERMIT# 113751 PIN# 4842-33-0962 DATE 7-18-03

OWNER OR CONTRACTOR LUTHER GREENWAY PHONE: Business Home 704-278-3189

ADDRESS 1260 CHILDERS ROAD, CLEVELAND, NC 27013

LOCATION US 21 N, TL JENNINGS ROAD, TL BYWAY LANE, 0.2 MILE, ON RIGHT, 400' BACK

SUBDIVISION BLOCK / SECTION LOT LOT AREA 15.27 ACRES SITE CLASS. PS DESIGN FLOW 480 L.T.A.R. 0.30 GPD/FT²

Septic Tank: 1000 Gallons; STB 1007 Date 12-19-03
Pump Tank: Gallons; PT Date
Pump Make: Model Serial No.
Nitrification Field: No Fields 1 Square Feet 1600 Linear Feet 533
No Lines FOUR Trench Width 36" Max Trench Bottom Depth 36" Gravel Depth 12"

☑ New System ☐ Repair System Type: I, II, III, IV, V, VI
System Description: CONVENTIONAL, GRAVITY
Repair System Description: CONVENTIONAL, GRAVITY
Maintenance Agreement Required: ☐ Yes ☑ No


☑ House/Mod. Home No. Bedrooms 4
☐ Mobile Home No. Bathrooms 2
☐ Business No. Employees
☐ Other
☐ Slab ☑ Crawl Space ☐ Basement w/plumbing ☐ Basement wo/plumbing

Water Supply: ☑ Individual ☐ Public ☐ Community WELL


Comments:/Conditions: (1) KEEP SYSTEM MINIMUM 100 FEET FROM WELL (2) SEPTIC TANK MAY BE RELOCATED TO FEED OPPOSITE END

Comments:/Conditions:
Tuff-Tite filter Installed + ST marker Installed
2, 3, 4th Lines checked OKay 3/12/04, Cof
-1st Line OKay 3/16/04 wof

INITIAL SITE SKETCH

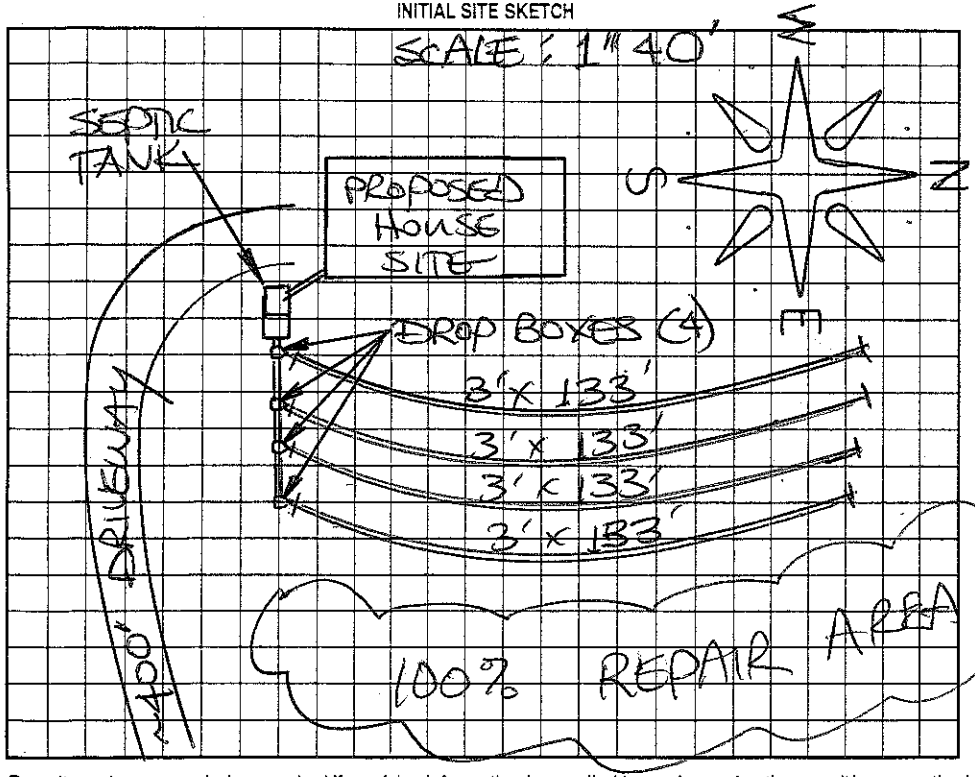

AS BUILT SKETCH

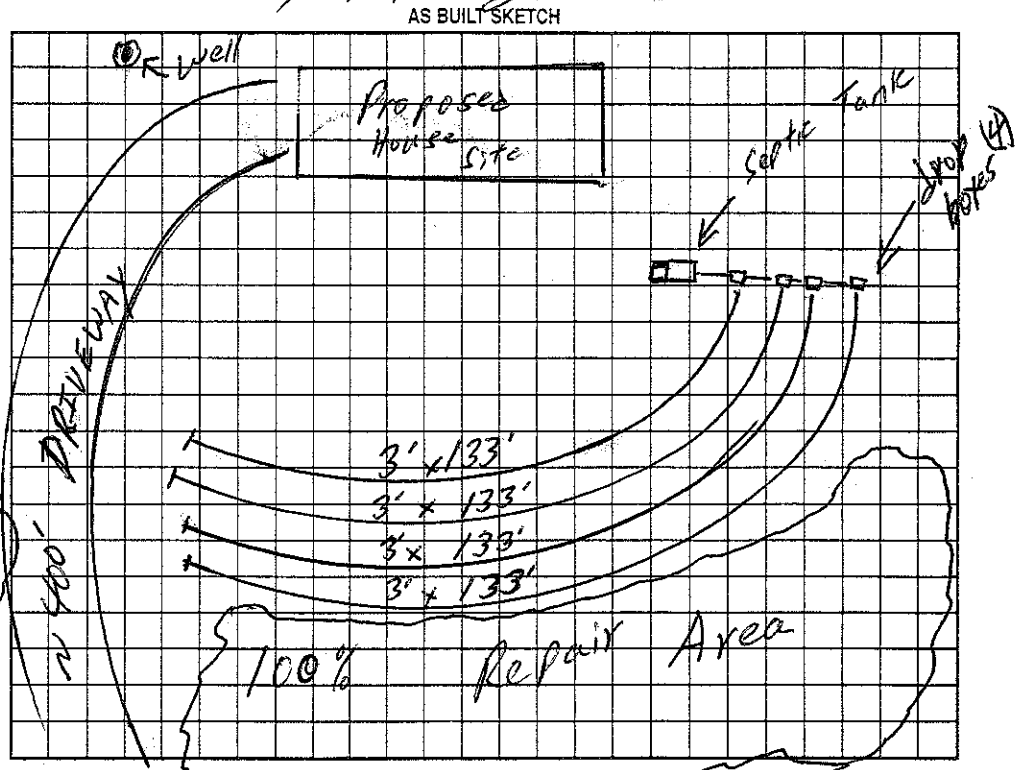

Permit can be suspended or revoked if any false information is supplied toward securing the permit/any unauthorized changes are made to the site/any unauthorized changes are made in the installation of the system. Improvement Permit with plat valid without expiration. Improvement Permit with site plan valid for sixty months. Authorization to Construct is valid for a period equal to that of Improvement Permit – not to exceed sixty months.

Signed: + Luther R. Greenway date 7-18-03 Installed by: Sammy Shoemaker

Improvement Permit by: STEVE HENDRICK date 7-18-03 Operation Permit by: William O. Johnson date 3/15/04

Authorization to Construct by: STEVE HENDRICK date 12-9-03 Existing System Inspection by: date

HEALTH DEPT. COPY: WHITE OWNER COPY (FINAL): YELLOW OWNER COPY (INITIAL): PINK