IREDELL COUNTY HEALTH DEPARTMENT

AUTHORIZATION TO CONSTRUCT

STATESVILLE 704-878-5305 MOORESVILLE 704-664-5281

IMPROVEMENT PERMIT / ~~CERTIFICATE OF COMPLETION~~ / OPERATION PERMIT / EXISTING SYSTEM INSPECTION

PROPERTY DESCRIPTION NO. 066628 DATE 6/4/97 TAX MAP NO. 4842 35 0987 Watershed: ☐ Yes ☑ No

OWNER OR CONTRACTOR MICHAEL KELLER PHONE: Business _____ Home 539-5109

ADDRESS 3435 JENNINGS RD UNION GROVE NC 28689

LOCATION 21N - TL JENNINGS RD - TL EUREKA SPRINGS - ON LT 1/4 MILE

SUBDIVISION KELLER BLOCK / SECTION _____ LOT 1 LOT AREA 1 AC SITE CLASS. PS DESIGN FLOW 240GPD L.T.A.R. .30PD/FT²

Septic Tank: 1000 Gallons; STB 1012 Date 4-30-97

Pump Tank: _____ Gallons; PT _____ Date _____

Pump Make: _____ Model _____ Serial No. _____

Nitrification Field: No Fields 1 Square Feet 801 Linear Feet 267

No Lines 4@67' Trench Width 36" Max Trench Bottom Depth 20" Gravel Depth 12"

☑ New System ☐ Repair System Type: (I) II, III, IV, V, VI

System Description: GRAVITY CONVENTIONAL

Repair System Description: SAME

Maintenance Agreement Required: ☐ Yes ☑ No

☐ House/Mod. Home ☑ Mobile Home ☐ Business ☐ Other

No. Bedrooms 2 No. Bathrooms 2 No. Employees ____


☐ Slab ☑ Crawl Space ☐ Basement w/plumbing ☐ Basement wo/plumbing

Water Supply: ☑ Individual ☐ Community ☐ Public


Comments: KEEP WELL 100' FROM SEPTIC SYSTEM AND 40' FROM PROPERTY LINES

Comments:

INITIAL SITE SKETCH

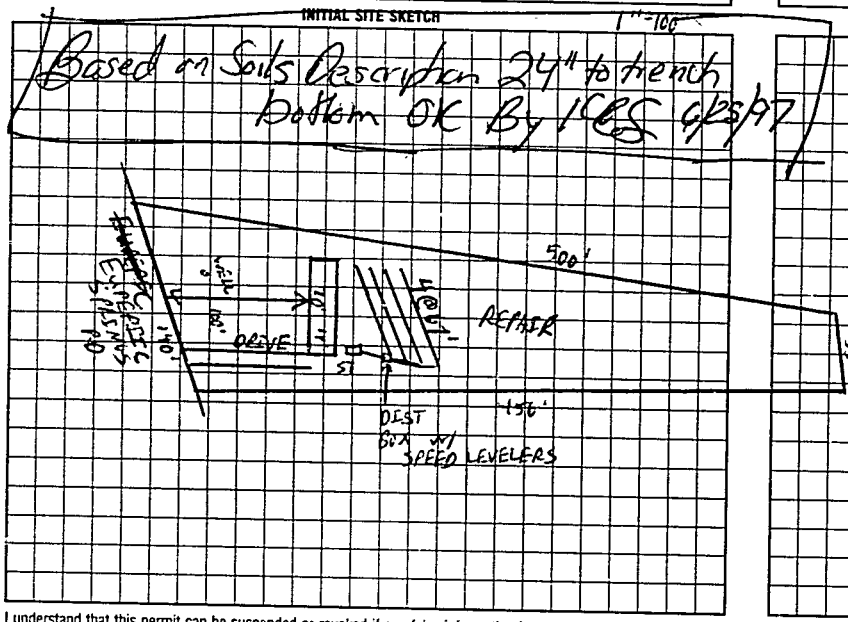

AS BUILT SKETCH

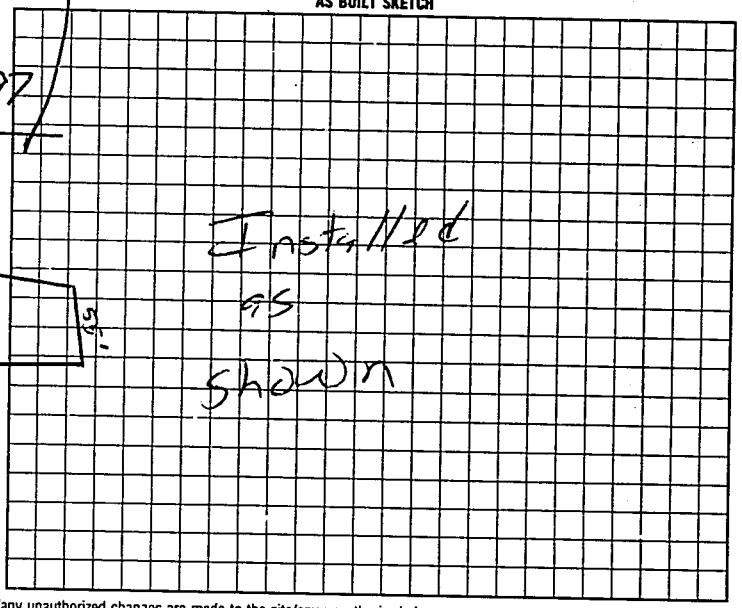

I understand that this permit can be suspended or revoked if any false information is supplied toward securing the permit/any unauthorized changes are made to the site/any unauthorized changes are made in the installation of the system. Improvement Permit is valid for 60 months from date of issuance.

Signed: Michael B Keller 6-4-97

Improvement Permit by: C. Ray Tolson date 6/4/97

~~Existing System Inspection by:~~ AUTHORIZATION TO CONSTRUCT C. Ray Tolson date 6/4/97

Installed by: Kenny Madison

Certificate of Completion by: _____ date _____

Operation Permit by: Mark Cox RS date 6-26-97

HEALTH DEPT. COPY: WHITE INSPECTION COPY (FINAL): GREEN OWNER COPY (FINAL): YELLOW INSPECTION COPY (INITIAL): PINK OWNER COPY (INITIAL): GOLD