IREDELL COUNTY HEALTH DEPARTMENT

AUTHORIZATION TO CONSTRUCT

STATESVILLE 704-878-5305 MOORESVILLE 704-664-5281

IMPROVEMENT PERMIT / ~~CERTIFICATE OF COMPLETION~~ / OPERATION PERMIT / EXISTING SYSTEM INSPECTION

PROPERTY DESCRIPTION NO. 066629 DATE 6/4/97 TAX MAP NO. 4842350987

OWNER OR CONTRACTOR MICHAEL KELLER PHONE: Business Home 539-5109 Watershed: ☐ Yes ☑ NO

ADDRESS 3435 JENNINGS RD UNION GROVE 28689

LOCATION 21 N TL JENNINGS RD - TL ELDERBEE RD - R MELTON RT

SUBDIVISION KELLER BLOCK / SECTION LOT 2 LOT AREA 1 AC SITE CLASS. BS DESIGN FLOW 360GPD L.T.A.R. .30GPD/FT

Septic Tank: 1000 Gallons; STB 1017 Date 4-30-97

Pump Tank: Gallons; PT Date

Pump Make: Model Serial No.

Nitrification Field: No Fields 1 Square Feet ~~440~~ 1200 Linear Feet 400

No Lines 6 @ 67' Trench Width 36" Max Trench Bottom Depth (20") Gravel Depth 12"

☑ New System ☐ Repair System Type: I (II) III, IV, V, VI

System Description: GRAVITY CONVENTIONAL

Repair System Description: SAME

Maintenance Agreement Required: ☐ Yes ☑ No

☐ House/Mod. Home No. Bedrooms 3

☑ Mobile Home No. Bathrooms 2

☐ Business No. Employees

☐ Other


☐ Slab ☑ Crawl Space ☐ Basement w/plumbing ☐ Basement wo/plumbing

Water Supply: ☑ Individual ☐ Community ☐ Public


Comments: KEEP WELL 100' FROM SEPTIC SYSTEM AND 40' FROM PROPERTY LINE

Comments:

INITIAL SITE SKETCH 1"=100'

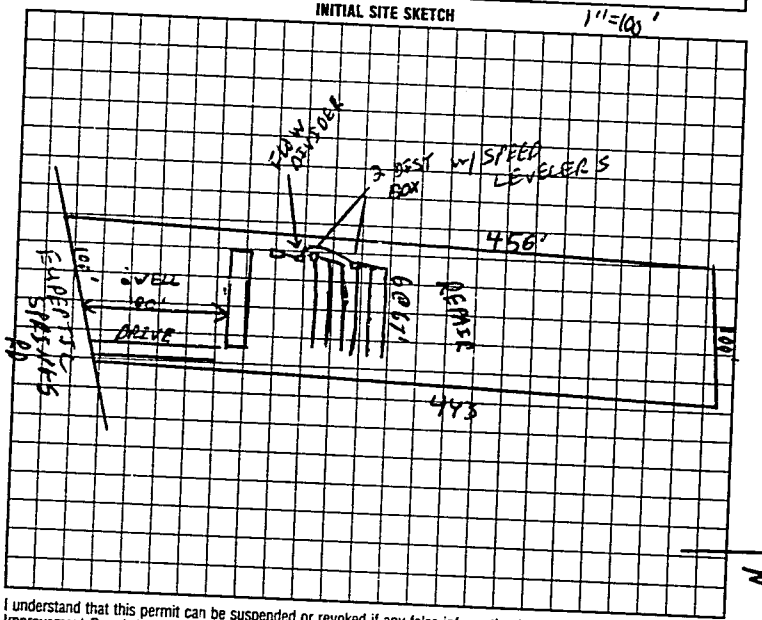

AS BUILT SKETCH

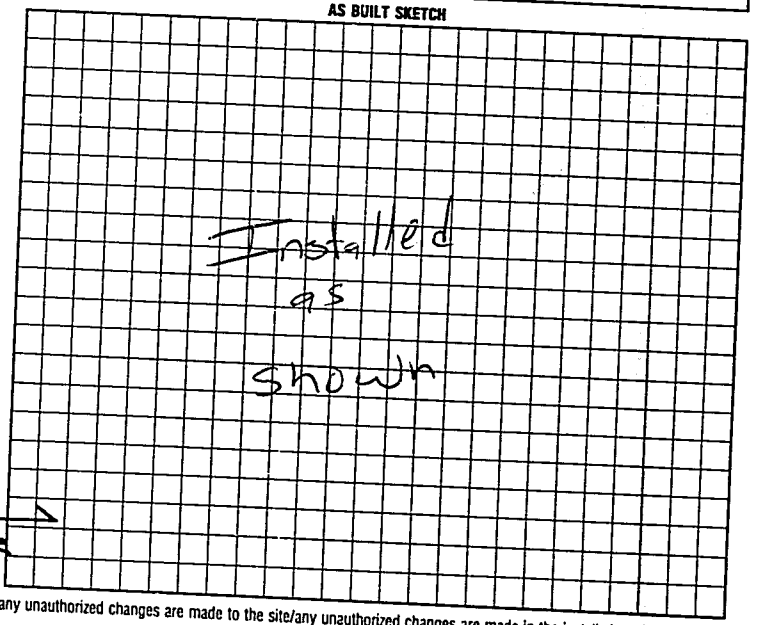

I understand that this permit can be suspended or revoked if any false information is supplied toward securing the permit/any unauthorized changes are made to the site/any unauthorized changes are made in the installation of the system. Improvement Permit is valid for 60 months from date of issuance.

Signed: Michael B Keller 6/4/97

Improvement Permit by: C. Ray Thomas date 6/4/97

AUTHORIZATION TO CONSTRUCT

~~Existing System Inspection by:~~ C. Ray Thomas date 6/4/97

Installed by: Kenny Madison

Certificate of Completion by:

Operation Permit by: Mark C Ouzts RS date 6-26-97

HEALTH DEPT. COPY: WHITE INSPECTION COPY (FINAL): GREEN OWNER COPY (FINAL): YELLOW INSPECTION COPY (INITIAL): PINK OWNER COPY (INITIAL): GOLD