IREDELL COUNTY HEALTH DEPARTMENT

STATESVILLE 704-878-5305 (@) (a) MOORESVILLE 704-664-5281

IMPROVEMENT PERMIT / AUTHORIZATION TO CONSTRUCT / OPERATION PERMIT / EXISTING SYSTEM INSPECTION

PERMIT # 156726 PIN # 4842358983 DATE 6/26/09

OWNER or APPLICANT Wm Martz Jr PHONE: Business Home: 704 746 7094

OWNER or APPLICANT ADDRESS 1131 Eupeptic Springs

LOCATION / DIRECTIONS 77N to (L) on Jennings Rd, (R) onto Eupeptic, immediately on (R)

SUBDIVISION n/a BLOCK / SECTION n/a LOT # n/a LOT AREA .8 DESIGN FLOW 360 L.T.A.R. 3

Septic Tank 1000 Gallons: STB 760 Date 7-24-09

Pump Tank Gallons: P T Date

Pump Make Model Serial #

Nitrification Field No Fields 1 No Lines 5 Linear Feet 300

Trench Width 36" Max. Trench Bottom Depth 36" Gravel Depth n/a

☒ New System ☐ Repair ☐ Expansion System Type I (II) III IV V VI

System Description: 25% Reduction Gravity

Repair System Description: 25% Reduction Pump

Maintenance Agreement Required ☐ YES ☒ NO

☒ GRAVITY ☐ PRESSURE

☒ Residence No. Bedrooms 3

☐ Business No. Persons

☐ Other No. Employees

☐ Slab ☒ Crawl Space

☐ Basement w/plumbing ☐ Basement w/o plumbing


Water Supply: ☐ Private ☒ Public ☐ Community

Comments / Conditions


Well must be abandoned before septic system is installed.

Comments / Conditions

INITIAL SITE SKETCH

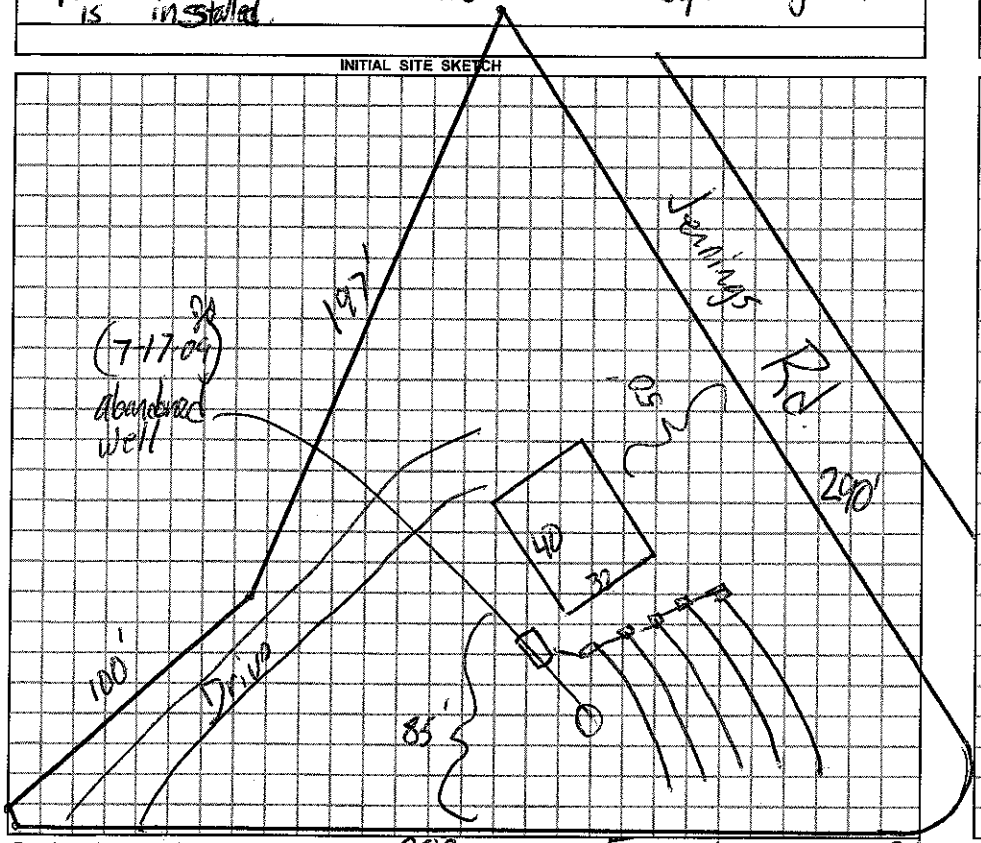

AS BUILT SKETCH

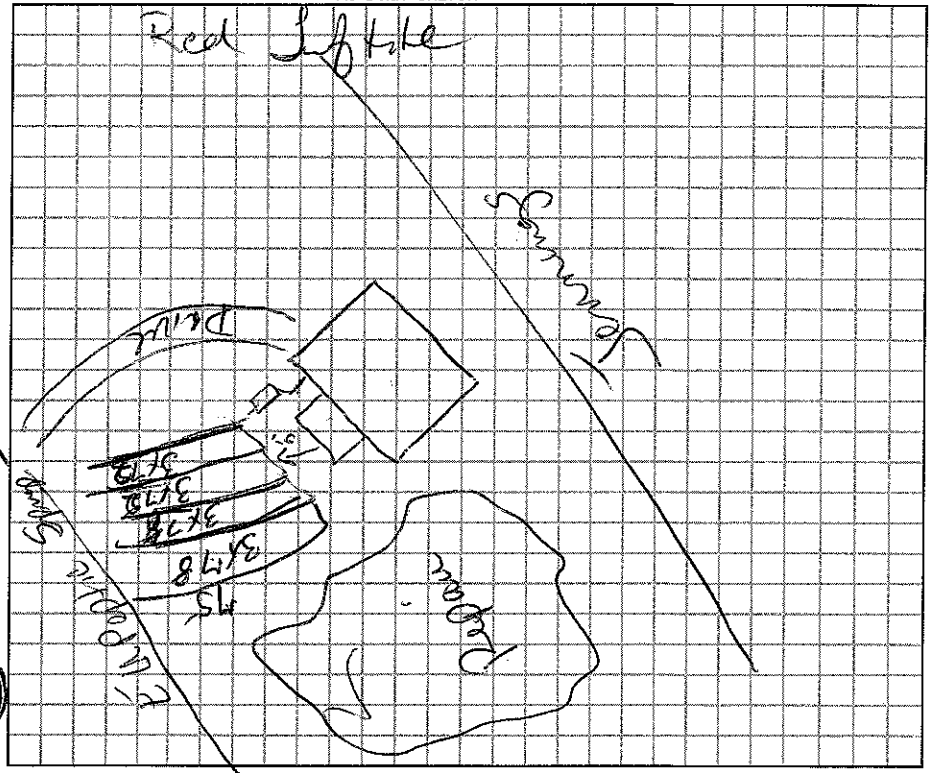

Permit can be suspended or revoked if any false information is supplied toward securing the permit / any unauthorized changes are made to the site / any unauthorized changes are made in the installation of the system.

☐ *IMPROVEMENT PERMIT w / plat valid without expiration.* ☒ *IMPROVEMENT PERMIT w / siteplan valid for 60 mos.* ☒ *AUTHORIZATION TO CONSTRUCT valid for period equal to IMPROVEMENT PERMIT-not to exceed 60 mo.*

Owner / Applicant Signature: Carol Martz Date 7/20/09

Improvement Permit by: James Date 6/24/09

Authorzation to Construct by: James Date 7/20/09

Installed by: A-7 Backhoe

Operation Permit by: Date: 8-14-09

Existing System Inspected by: Date:

YOU SHOULD CONTACT A LOCATOR SERVICE PRIOR TO ANY EXCAVATION.

WHITE COPY Environmental Health YELLOW COPY (Final) Owner / Applicant PINK COPY (Initial) Owner / Applicant