IREDELL COUNTY HEALTH DEPARTMENT

AUTHORIZATION TO CONSTRUCT

STATESVILLE 704-878-5305 MOORESVILLE 704-664-5281

IMPROVEMENT PERMIT / ~~CERTIFICATE OF COMPLETION~~ / OPERATION PERMIT / EXISTING SYSTEM INSPECTION

PROPERTY DESCRIPTION NO. 066632 DATE 6/4/97 TAX MAP NO. 4842350987 Watershed: ☐ Yes ☑ No

OWNER OR CONTRACTOR MICHAEL B KELLER PHONE: Business _____ Home 704-539-5109

ADDRESS 3435 JENNINGS RD UNION GROVE 28689

LOCATION 21 N - TL JENNINGS RD - TL EUREPTIC SPRING ¼ MILE ON RT

SUBDIVISION KELLER BLOCK / SECTION _____ LOT 4 LOT AREA 1 AC SITE CLASS. PS DESIGN FLOW 240GPD L.T.A.R. 364 SQ/FT

Septic Tank: 1000 Gallons; STB 1017 Date 4-27-97

Pump Tank: _____ Gallons; PT _____ Date _____

Pump Make: _____ Model _____ Serial No. _____

Nitrification Field: No Fields 1 Square Feet ~~540~~ 801 Linear Feet 267

No Lines 4 @ 67' Trench Width 36" Max Trench Bottom Depth 20" Gravel Depth 12"

☑ New System ☐ Repair System Type: I (II) III, IV, V, VI

System Description: GRAVITY CONVENTIONAL

Repair System Description: SAME

Maintenance Agreement Required: ☐ Yes ☑ No

☐ House/Mod. Home ☑ Mobile Home ☐ Business ☐ Other

No. Bedrooms 3 No. Bathrooms 2 No. Employees _____


☐ Slab ☑ Crawl Space ☐ Basement w/plumbing ☐ Basement wo/plumbing

Water Supply: ☑ Individual ☐ Community ☐ Public

Comments: KEEP WELL 100' FROM SEPTIC SYSTEM AND 40' FROM PROPERTY LINE

Comments:

INITIAL SITE SKETCH 1"=100'

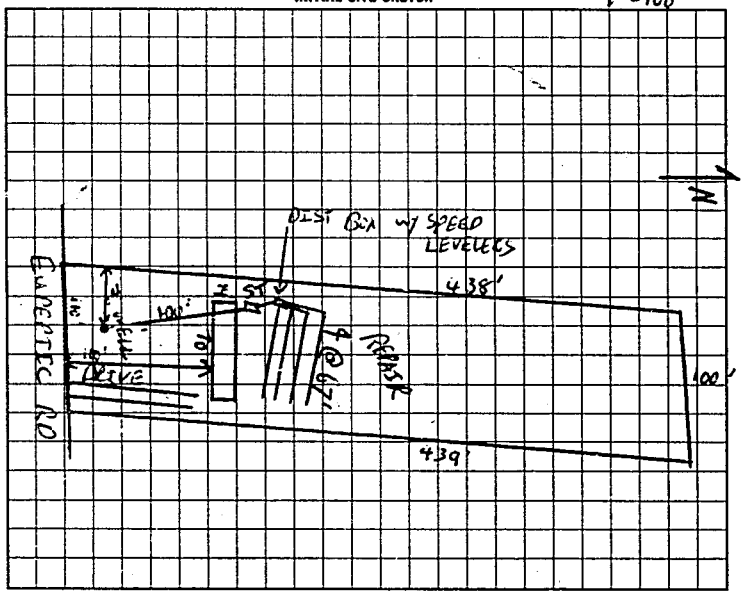

AS BUILT SKETCH

Installed as shown

I understand that this permit can be suspended or revoked if any false information is supplied toward securing the permit/any unauthorized changes are made to the site/any unauthorized changes are made in the installation of the system. Improvement Permit is valid for 60 months from date of issuance.

Signed: Michael B Keller 6/4/97

Improvement Permit by: AUTHORIZATION date 6/4/97

~~Drinking System Inspection by~~ _____ date 6/4/97

Installed by: Kenny Madison

Certificate of Completion by: _____ date _____

Operation Permit by Mary C. Curtis date 6-27-97

HEALTH DEPT. COPY. WHITE INSPECTION COPY (FINAL) GREEN OWNER COPY (FINAL) YELLOW INSPECTION COPY (INITIAL) PINK OWNER COPY (INITIAL) GOLD

S 87100