# IREDELL COUNTY HEALTH DEPARTMENT

THIS PERMIT VOIDS PREVIOUS ISSUED 2-18-02

STATESVILLE 704-878-5305 (C1) MOORESVILLE 704-664-5281

## IMPROVEMENT PERMIT / AUTHORIZATION TO CONSTRUCT / OPERATION PERMIT / EXISTING SYSTEM INSPECTION

PERMIT# 104464 PIN# 4842-38-4399.1

OWNER OR CONTRACTOR MARK HAWKINS DATE 9-16-02

ADDRESS 3333 JENNINGS ROAD, TURNERSBURG NC 28688 PHONE: Business 704-500-5880 Home 704-539-4222

LOCATION US 21 N, TL JENNINGS ROAD, TL INDIAN HILL ROAD, 0.1 MILE ON LEFT

SUBDIVISION _____ BLOCK / SECTION _____ LOT _____ LOT AREA 3.5 ACRES SITE CLASS PS DESIGN FLOW 360 L.T.A.R. 0.30 gpd/ft²

Septic Tank: 1000 Gallons; STB 760 Date 6-26-02

Pump Tank: _____ Gallons; PT _____ Date _____

Pump Make: _____ Model _____ Serial No _____

Nitrification Field: No Fields 1 Square Feet 750 Linear Feet 266

No Lines TWO Trench Width 36" Max Trench Bottom Depth 36" Gravel Depth 12"

☑ New System ☐ Repair System Type: I (II) III IV V VI

System Description: CONVENTIONAL GRAVITY

Repair System Description: CONVENTIONAL PUMP

Maintenance Agreement Required: ☐ Yes ☑ No

☑ House/Mod Home No. Bedrooms 3

☐ Mobile Home No. Bathrooms 2 1/2

☐ Business No. Employees _____

☐ Other _____


☐ Slab ☐ Crawl Space ☑ Basement w/plumbing ☐ Basement wo/plumbing

Water Supply: ☐ Individual ☑ Public ☐ Community

Comments/Conditions: NEW SYSTEM TIED INTO EXISTING THROUGH EXISTING SEPTIC TANK AS SHOWN

Comments/Conditions: SEPTIC TANK WITH MARKER INSTALLED USING "ZABEL" FILTER

INITIAL SITE SKETCH

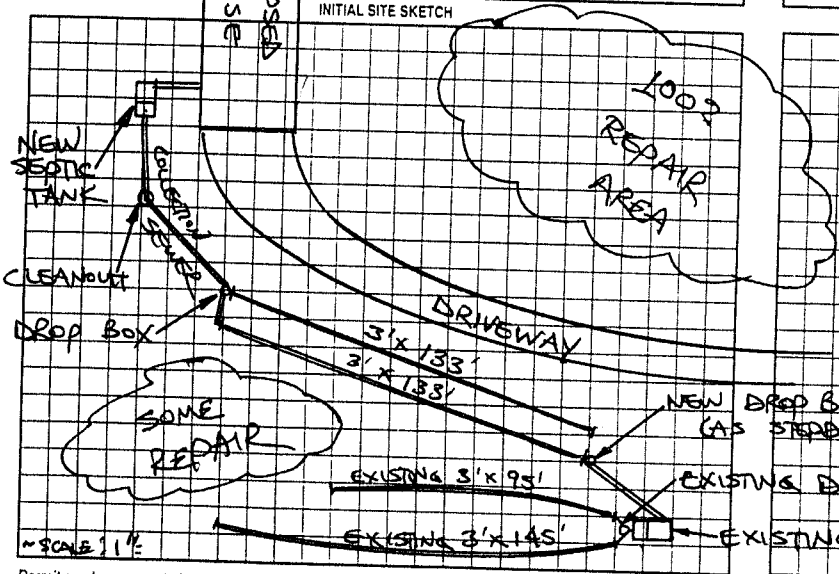


AS BUILT SKETCH

SYSTEM INSTALLED ACCORDING TO INITIAL SITE SKETCH

Permit can be suspended or revoked if any false information is supplied toward securing the permit/any unauthorized changes are made to the site/any unauthorized changes are made in the installation of the system. Improvement Permit with plat valid without expiration. Improvement Permit with site plan valid for sixty months. Authorization to Construct is valid for a period equal to that of Improvement Permit – not to exceed sixty months

Signed: Mark Hawk date 9-17-02 Installed by: BRENT GALLIHER

Improvement Permit by: STEVE HEDRICK date 9-16-02 Operation Permit by: STEVE HEDRICK date 10-18-02

Authorization to Construct by: STEVE HEDRICK date 9-16-02 Existing System Inspection by: _____ date _____

HEALTH DEPT COPY WHITE OWNER COPY (FINAL) YELLOW OWNER COPY (INITIAL) PINK