IREDELL COUNTY HEALTH DEPARTMENT - *ENVIRONMENTAL HEALTH* ☐ STATESVILLE OFFICE 704-878-5305 ☐ MOORESVILLE OFFICE 704-664-5281

IMPROVEMENT PERMIT / AUTHORIZATION TO CONSTRUCT / OPERATION PERMIT / EXISTING SYSTEM INSPECTION

PERMIT # 165966 PIN # 4842-46-1477 DATE 9 May 2011

OWNER Joe Johnson APPLICANT: K.W. Nicholson PHONE: Home/Cell # (704) 902-0799 Business #

SITE ADDRESS 3148 Jennings Rd. Olin OWNER / APPLICANT ADDRESS

SITE DIRECTIONS Hwy 21 N Th Jennings Rd. 2nd drive on Rt. past Eupeptic Spring Rd.


SUBDIVISION BLOCK / SECTION LOT # LOT AREA DESIGN FLOW 480 gpd L.T.A.R. 0.3 gpd/sq ft

Septic Tank 1000	Gallons: STB 1012	Date 9-15-10	☑ New System ☐ Repair ☐ Expansion System Type I II (III) IV V VI	☑ Residence	No. Bedrooms 4	Water Supply
Pump Tank	Gallons: P T	Date	System Description: 25% Reduction	☐ Business	No. Persons	☑ Private
Pump Make	Model	Serial #	Repair System Description: 25% Reduction	☐ Other	No. Employees	☐ Public
No. Nitrification Fields: 1	No. Lines 4	Linear Feet 400	Maintenance Agreement Required ☐ YES ☑ NO	☐ Slab	☑ Crawl Space	☐ Community
Trench Width 36"	Max. Trench Bottom Depth 36"	Gravel Depth N/A	☑ GRAVITY ☐ PRESSURE	☐ Basement w/plumbing	☐ Basement w/o plumbing	


Comments / Conditions Follow contour

5T HAS marker / Poly bdc filter

INITIAL SITE SKETCH

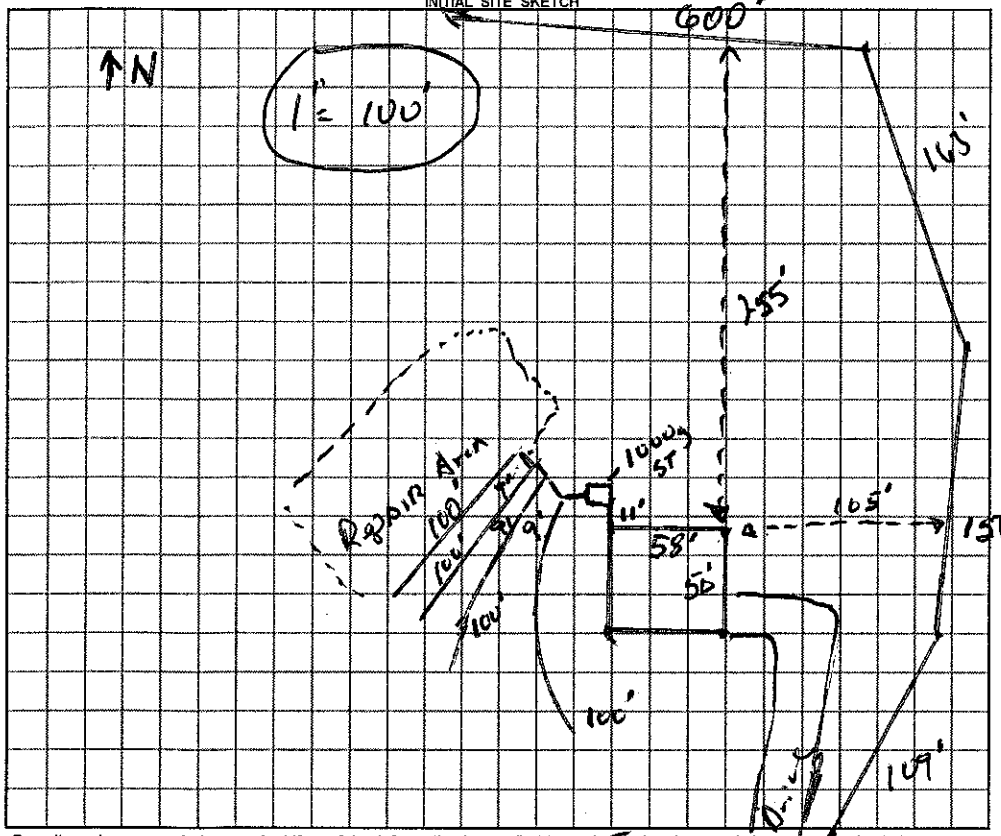

AS BUILT SKETCH

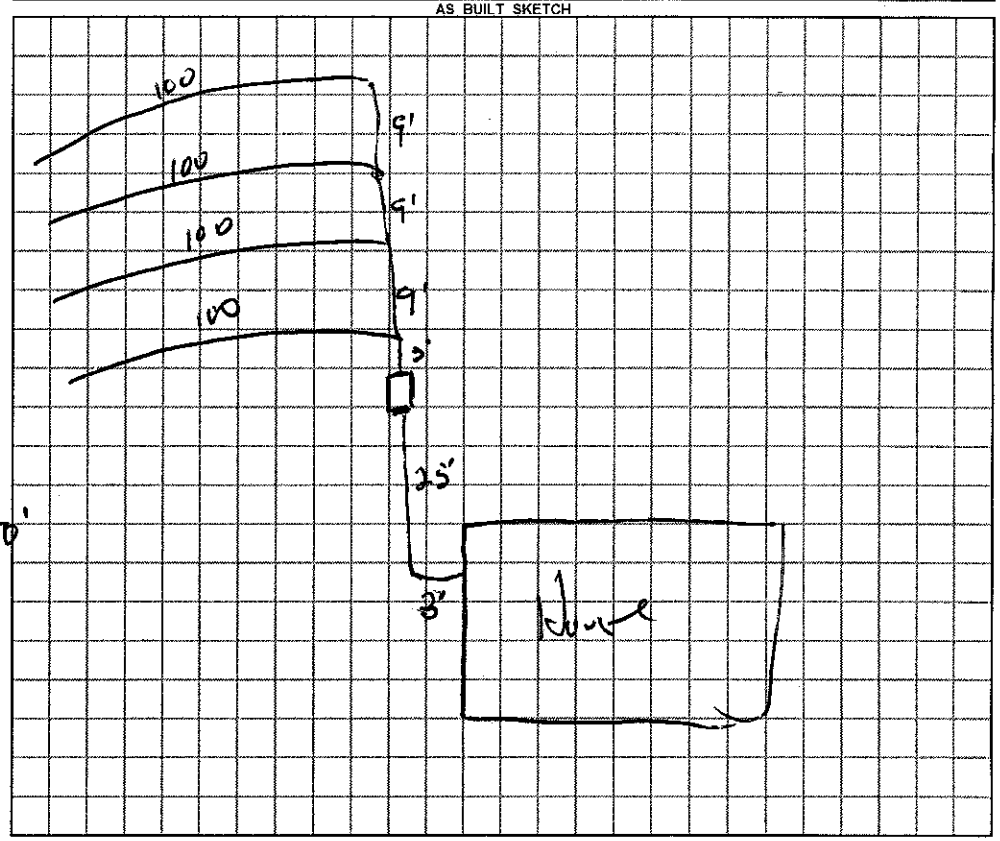

Permit can be suspended or revoked if any false information is supplied toward securing the permit / any unauthorized changes are made to the site / any unauthorized changes are made in the installation of the system.

☐ ***IMPROVEMENT PERMIT*** with plat valid without expiration. ☑ ***IMPROVEMENT PERMIT*** with plat valid without expiration and plan valid 60 mo. ☑ ***AUTHORIZATION TO CONSTRUCT*** valid for period equal to IMPROVEMENT PERMIT--not to exceed 60 mo.

Owner / Applicant Signature: K.W. Nicholson 5-16-11 Date

Installed by: David Young

IMPROVEMENT PERMIT by: REHS Date 13 May 11

OPERATION PERMIT by: REHS Date 13 Sept. 11

AUTHORIZATION TO CONSTRUCT by: REHS Date 13 May 11

Existing System Inspected by: REHS Date

YOU SHOULD CONTACT A LOCATOR SERVICE PRIOR TO ANY EXCAVATION

White Copy -- Environmental Health YELLOW COPY (Final) Owner / Applicant PINK COPY (Initial) Owner / Applicant