IREDELL COUNTY HEALTH DEPARTMENT

STATESVILLE 704-878-5305 (c1) MOORESVILLE 704-664-5281

IMPROVEMENT PERMIT / AUTHORIZATION TO CONSTRUCT / OPERATION PERMIT / EXISTING SYSTEM INSPECTION

PERMIT# 095373 PIN# 4842 47 2256 DATE

OWNER OR CONTRACTOR JIMMY HICKS PHONE: Business 704-872-7661 Home 704-539-4867

ADDRESS 3216 JENNINGS ROAD, OLIN, NC 28660

LOCATION US 21N, TL JENNINGS ROAD, ON RIGHT AT ROCKY CREEK AT BOX #3216

SUBDIVISION BLOCK / SECTION LOT LOT AREA 7.23 ACRES SITE CLASS PS DESIGN FLOW 240 L.T.A.R. 0.30 GPD/FT²

Septic Tank: 1000 Gallons: STB 1012 Date 9-17-01
Pump Tank: Gallons: PT Date
Pump Make: Model Serial No
Nitrification Field: No Fields 1 Square Feet EQ TO 810 Linear Feet 200
No Lines THREE Trench Width 36" Max Trench Bottom Depth 30" Gravel Depth NA

☑ New System ☐ Repair System Type: I, II, III, IV, V
System Description: 25% REDUCTION GRAVITY
Repair System Description: EXISTING, CONVENTIONAL GRAVITY
Maintenance Agreement Required: ☐ Yes ☑ No


☑ House/Mod. Home ☐ Mobile Home ☐ Business ☐ Other
No. Bedrooms 2 No. Bathrooms 2 No. Employees
☐ Slab ☐ Crawl Space ☐ Basement w/plumbing ☐ Basement wo/plumbing

Water Supply: ☑ Individual ☐ Public ☐ Community WELL

Comments:/Conditions: INSTALL 25% REDUCTION SYSTEM IN THREE LINES AS SHOWN ON CONTOUR

Comments /Conditions: SEPTIC TANK WITH MARKER INSTALLED USING "POLYLOK" FILTER

INITIAL SITE SKETCH

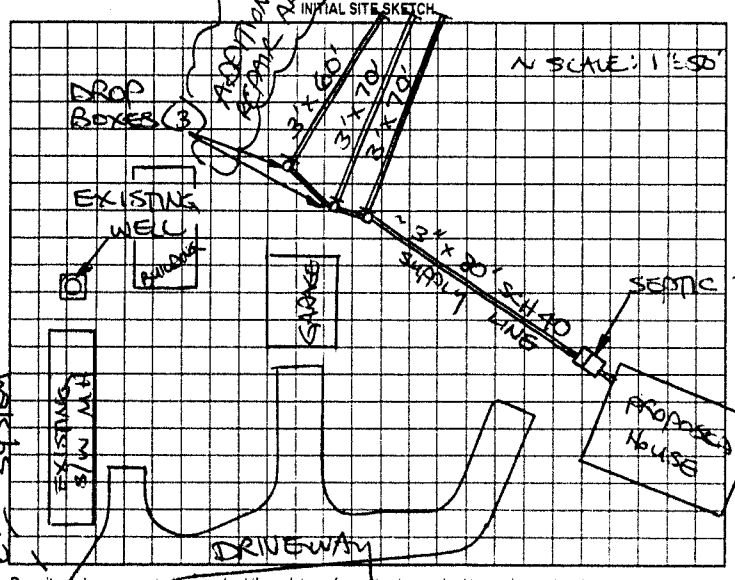

AS BUILT SKETCH

SYSTEM INSTALLED ACCORDING TO INITIAL SITE SKETCH

Permit can be suspended or revoked if any false information is supplied toward securing the permit; any unauthorized changes are made to the site; any unauthorized changes are made in the installation of the system. Improvement Permit with plat valid without expiration. Improvement Permit with site plan valid for sixty months. Authorization to Construct is valid for a period equal to that of Improvement Permit – not to exceed sixty months.

Signed: x Jimmy Hicks date 1-25-02 Installed by: STEVE JORDAN

Improvement Permit by: STEVE HEDRICK date 1-25-02 Operation Permit by: STEVE HEDRICK date 3-5-02

Authorization to Construct by: STEVE HEDRICK date 1-25-02 Existing System Inspection by: date

HEALTH DEPT COPY WHITE OWNER COPY (FINAL) YELLOW OWNER COPY (INITIAL) PINK