Statesville office

IMPROVEMENT PERMIT / AUTHORIZATION TO CONSTRUCT / OPERATION PERMIT / EXISTING SYSTEM

PERMIT # 220893

APPLICANT: STEVEN BELL — APPLICANT ADDRESS: 214 WEBB ST. STATESVILLE, NC

PIN # 4842-39-9197

SITE ADDRESS: 3317 JENNINGS RD. UNION GROVE — PHONE: 704-880-0011 ALT. PHONE:

SITE DIRECTIONS: 77N, EXIT 65, TL, TL JENNINGS, ON R


SUBDIVISION: — SECTION: — LOT # — LOT AREA: 3.14 AC — DESIGN FLOW: 240 — L.T.A.R.: .3

Septic Tank	1000 (gal)	STB		Date		☒ New System	☐ Repair	☐ Expansion	System Type: I II (III) IV V VI
Pump Tank	(gal)	PT		Date		System Description:	25% REDUCTION		
Pump Make		Model		Serial #		Repair System Description:	SAME		
# Nitrification Fields	1	# Lines	2C100'	Linear Ft:	200'	Maintenance Agreement Required:	☐ YES	☒ NO	
Trench Width	36"	Max. Trench Bottom Depth	24"	Gravel Depth			☒ GRAVITY	☐ PRESSURE	


☒ Residence — No. Bedrooms: 2 — Water Supply: ☐ Private
☐ Business — No. Persons: 4 — ☒ Public
☐ Other — No. Employees: — ☐ Community
☐ Slab — ☒ Crawl Space
☐ Basement w/plumbing — ☐ Basement w/o plumbing

Comments / Conditions:

INITIAL SITE SKETCH

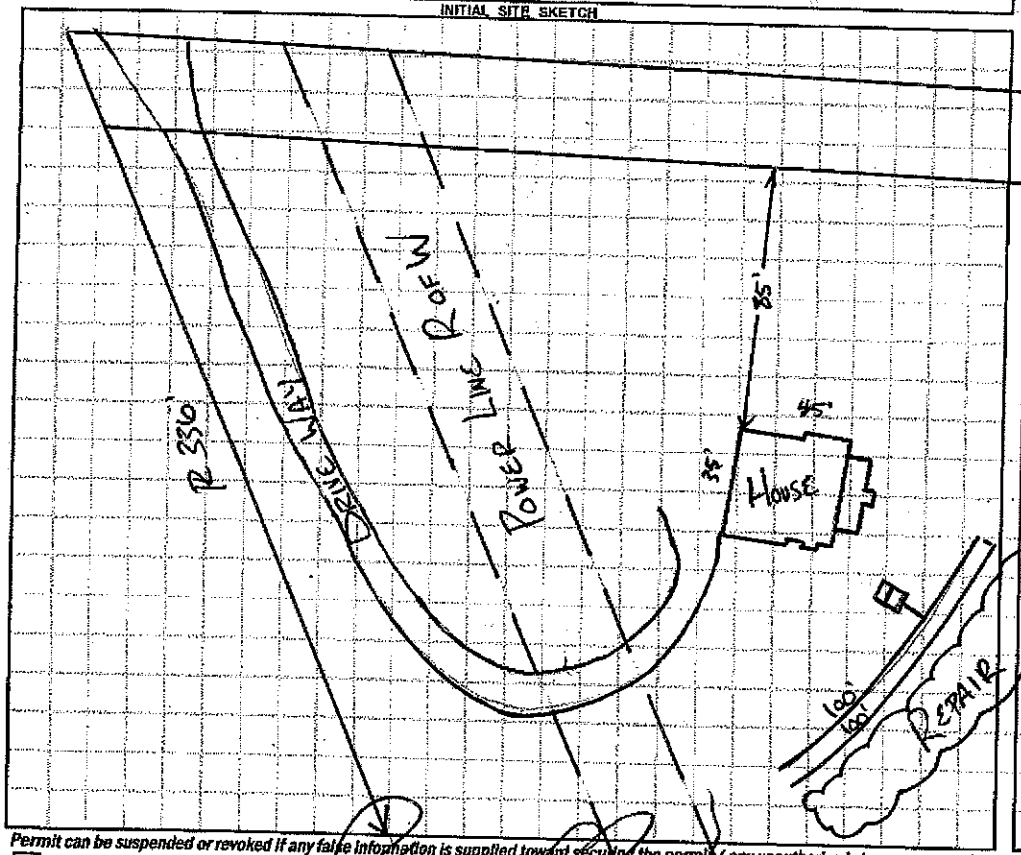

AS BUILT SKETCH

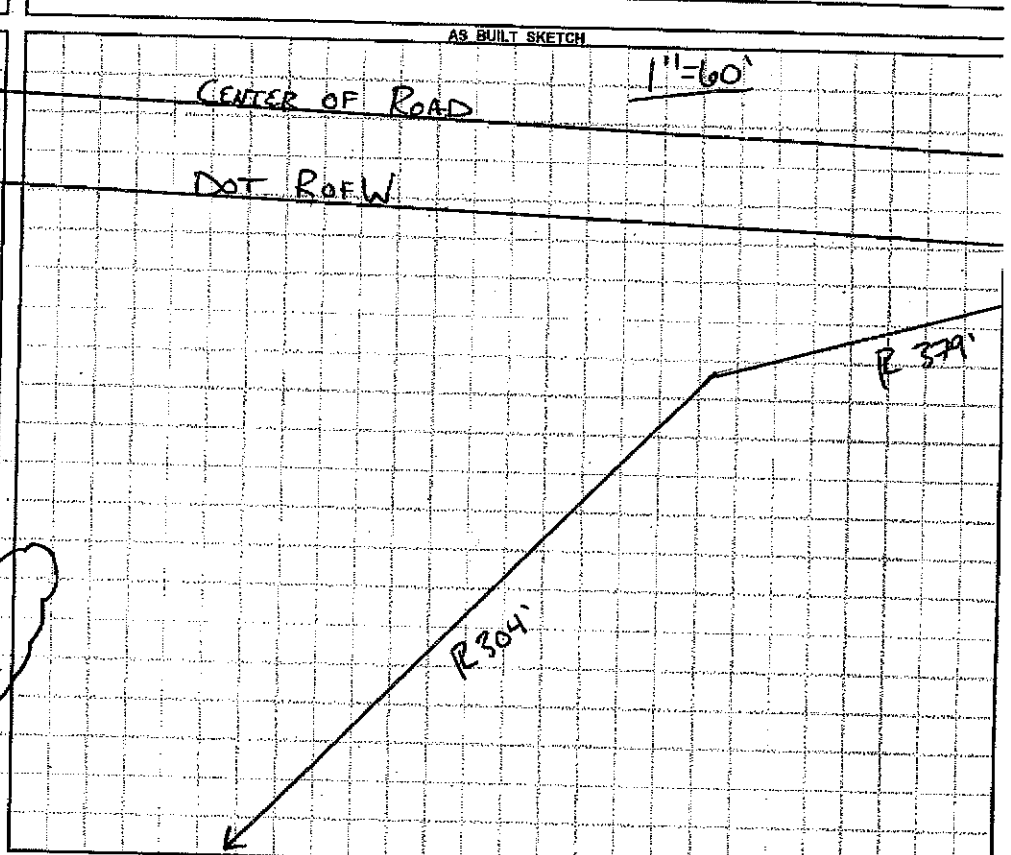

Permit can be suspended or revoked if any false information is supplied toward securing the permit / any unauthorized changes are made to the site / any unauthorized changes are made in the installation of the system. **CONTACT A LOCATOR SERVICE PRIOR TO ANY EXCAVATION**

☐ **IMPROVEMENT PERMIT** *with plat valid without expiration.* ☒ **IMPROVEMENT PERMIT** *with site plan valid for 60 mos.* ☒ **AUTHORIZATION TO CONSTRUCT** *valid for period equal to IMPROVEMENT PERMIT--not to exceed 60 mo.*

Owner / Applicant Signature: Steven Bell — Date: 9-30-16 — Installed by: STEVE JORDAN

IMPROVEMENT PERMIT by: RA Ellis — Date: 9-27-16 — OPERATION PERMIT by: RA Ellis — Date: 1-27-17

AUTHORIZATION TO CONSTRUCT by: RA Ellis — Date: 9-27-16 — Existing System Inspected by: — Date:

Health Dept. Copy - WHITE Applicant (Final Approval) - YELLOW Applicant (Conditional Approval) - PINK