IREDELL COUNTY HEALTH DEPARTMENT

STATESVILLE 704-878-5305 MOORESVILLE 704-664-5281

IMPROVEMENT PERMIT / AUTHORIZATION TO CONSTRUCT / OPERATION PERMIT / EXISTING SYSTEM INSPECTION

PERMIT# 077313 PIN# 4842 49 8945 DATE 11-12-98

OWNER OR CONTRACTOR DENNIS SAULTHER PHONE: Business Home 539-4544

ADDRESS 3349 JENNINGS ROAD, UNION GROVE, NC 28689

LOCATION I-77 N, TL NC 901, TL JENNINGS ROAD, ~0.5 MILE ON LEFT

SUBDIVISION BLOCK / SECTION LOT LOT AREA 4.0 ACRES SITE CLASS PS DESIGN FLOW 240 L.T.A.R. 0.25 GPD/FT²

Septic Tank: 1000 Gallons; STB 1012 Date 11-7-98
Pump Tank: Gallons; PT Date
Pump Make: Model Serial No.
Nitrification Field: No Fields 1 Square Feet 960 Linear Feet 320
No Lines Four Trench Width 36" Max Trench Bottom Depth 30"

☑ New System ☐ Repair System Type: (I) II III IV V VI
System Description: CONVENTIONAL GRAVITY
Repair System Description: CONV. GRAVITY
Maintenance Agreement Required: ☐ Yes ☑ No
Gravel Depth 12" ☐ Slab ☐ Crawl Space ☑ Basement w/plumbing ☐ Basement wo/plumbing


☑ House/Mod. Home ☐ Mobile Home ☐ Business ☐ Other
No. Bedrooms 3 No. Bathrooms 2½ No. Employees

Water Supply: ☐ Individual ☑ Public ☐ Community


Comments:/Conditions:
DROP BOXES

Comments:/Conditions:
*Tank set closer bedroom line - 7' off from house

INITIAL SITE SKETCH SCALE: 1"=40'

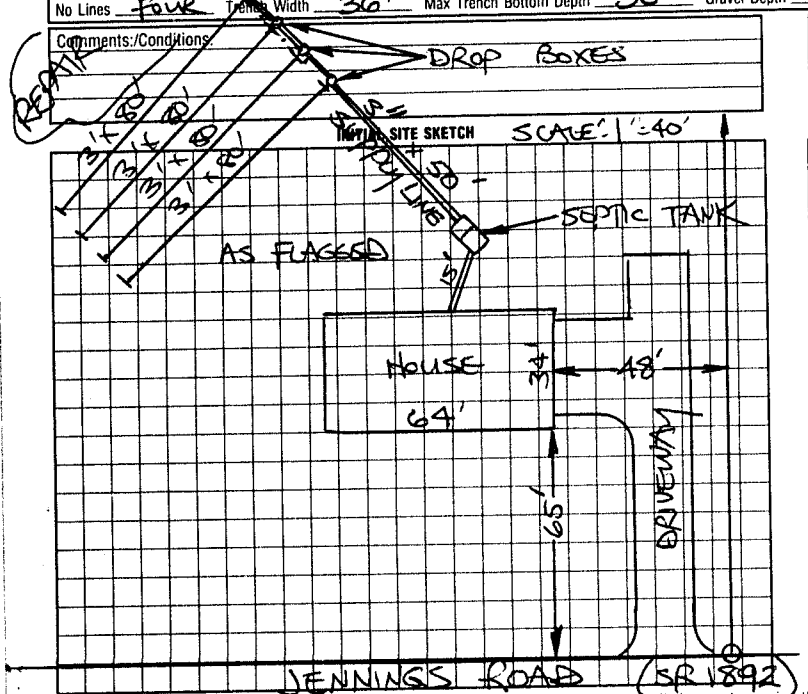

AS BUILT SKETCH

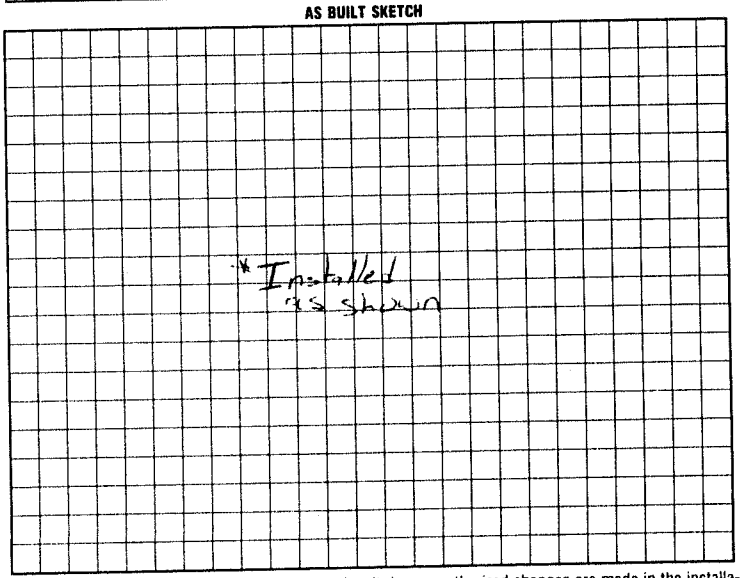

I understand that this permit can be suspended or revoked if any false information is supplied toward securing the permit/any unauthorized changes are made to the site/any unauthorized changes are made in the installation of the system. Improvement Permit with plat valid without expiration. Improvement Permit with site plan valid for sixty months. Authorization to Construct is valid for a period equal to that of Improvement Permit – not to exceed sixty months.

Signed: X Dennis Dalther date 11-12-98 Installed by: A-1 Backhoe

Improvement Permit by: STEVE HEDRICK date 11-12-98 Operation Permit by: [illegible] date 4-6-99

Authorization to Construct by: STEVE HEDRICK date 11-12-98 Existing System Inspection by: date

HEALTH DEPT. COPY: WHITE INSPECTION COPY (FINAL) GREEN OWNER COPY (FINAL) YELLOW INSPECTION COPY (INITIAL) PINK OWNER COPY (INITIAL) GOLD