IREDELL COUNTY HEALTH DEPARTMENT

STATESVILLE 704-878-5305 MOORESVILLE 704-664-5281

IMPROVEMENT PERMIT / AUTHORIZATION TO CONSTRUCT / OPERATION PERMIT / EXISTING SYSTEM INSPECTION

PERMIT# 084065 PIN# 4842 50 5448 DATE 10-15-99

OWNER OR CONTRACTOR HAROLD W. TOMLIN PHONE: Business Home 539-5477

ADDRESS 161 TRUMPET BRANCH ROAD, OLIN, NC 28660

LOCATION US 21 N, TL JENNINGS ROAD, ~0.2 MILE ON RIGHT PAST TRUMPET BRANCH ROAD

SUBDIVISION BLOCK / SECTION LOT LOT AREA 6.05 ACRES SITE CLASS PS DESIGN FLOW 360 L.T.A.R. 0.30 GPD/FT²

Septic Tank: 1000 Gallons; STB 620 Date 9-4-00
Pump Tank: Gallons; PT Date
Pump Make: Model Serial No.
Nitrification Field: No Fields 1 Square Feet 1200 Linear Feet 400
No Lines THREE Trench Width 36" Max Trench Bottom Depth 36" Gravel Depth 12"

☑ New System ☐ Repair System Type: I (II) III IV V VI
System Description: CONVENTIONAL GRAVITY
Repair System Description: CONV. GRAVITY
Maintenance Agreement Required: ☐ Yes ☑ No

☑ House/Mod. Home No. Bedrooms 3
☐ Mobile Home No. Bathrooms 2
☐ Business No. Employees
☐ Other
☐ Slab ☑ Crawl Space ☐ Basement w/plumbing ☐ Basement wo/plumbing


Water Supply: ☐ Individual ☑ Public ☐ Community

Comments/Conditions:


Comments/Conditions: SEPTIC TANK WITH RISERS INSTALLED USING "TUFTITE" FILTER

SCALE: 1"=50'

INITIAL SITE SKETCH

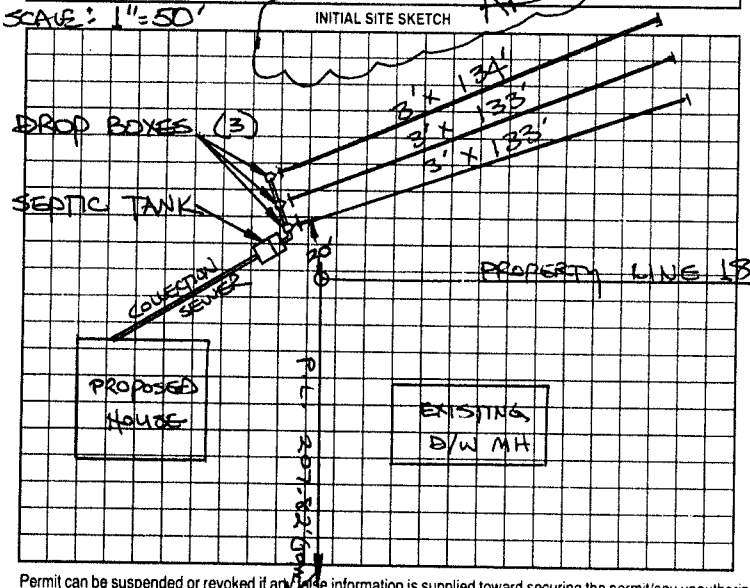

AS BUILT SKETCH

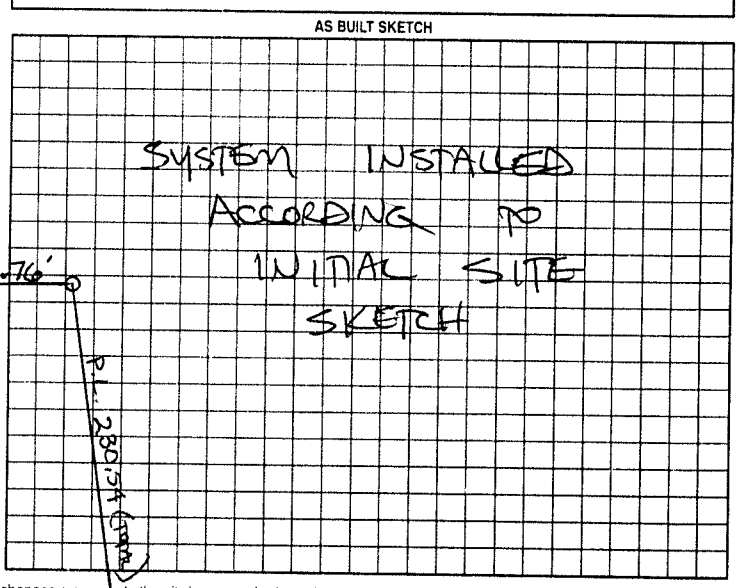

Permit can be suspended or revoked if any false information is supplied toward securing the permit/any unauthorized changes are made to the site/any unauthorized changes are made in the installation of the system. Improvement Permit with plat valid without expiration. Improvement Permit with site plan valid for sixty months. Authorization to Construct is valid for a period equal to that of Improvement Permit – not to exceed sixty months.

Signed: + Rodney Campbell date 10-15-99 Installed by: KENNY MADISON

Improvement Permit by: STEVE HEDRICK date 10-15-99 Operation Permit by: STEVE HEDRICK date 10-31-00

Authorization to Construct by: STEVE HEDRICK date 10-15-99 Existing System Inspection by: date

HEALTH DEPT. COPY WHITE OWNER COPY (FINAL) YELLOW OWNER COPY (INITIAL) PINK