IREDELL COUNTY HEALTH DEPARTMENT

STATESVILLE 704-878-5305 MOORESVILLE 704-664-5281

IMPROVEMENT PERMIT / AUTHORIZATION TO CONSTRUCT / OPERATION PERMIT / EXISTING SYSTEM INSPECTION

PERMIT# 071030 PIN# 4842 58 6528 DATE 1-2-98

OWNER OR CONTRACTOR CALVARY BAPTIST CHURCH PHONE: Business Home 539-5343

ADDRESS 329 INDIAN HILL ROAD, UNION GROVE, NC 28689

LOCATION I-77 N, TL NC 901, TL SLOANS MILL, TR INDIAN HILL ROAD, 1.0 MILE ON LEFT

SUBDIVISION BLOCK / SECTION LOT LOT AREA AMPLE SITE CLASS. PS DESIGN FLOW 450 L.T.A.R. 0.30 GPD/FT²

Septic Tank: 1000 Gallons; STB JD12 Date 9-22-97
Pump Tank: Gallons; PT Date
Pump Make: Model Serial No.
Nitrification Field: No Fields 1 Square Feet 1500 Linear Feet 500
No Lines SIX Trench Width 36" Max Trench Bottom Depth 36" Gravel Depth 12"

☑ New System ☐ Repair System Type: I, (II), III, IV, V, VI
System Description: CONVENTIONAL GRAVITY
Repair System Description: MAX. FEASIBLE AREA
Maintenance Agreement Required: ☐ Yes ☑ No

☐ House/Mod. Home No. Bedrooms
☐ Mobile Home No. Bathrooms
☐ Business No. Employees
☑ Other CHURCH OFFICE / FELLOWSHIP HALL


☐ Slab ☑ Crawl Space ☐ Basement w/plumbing ☐ Basement wo/plumbing

Water Supply: ☐ Individual ☑ Public ☐ Community

Comments:/Conditions: ① SYSTEM SIZED TO ACCOMODATE OFFICE, EXISTING SANCTUARY & FUTURE FELLOWSHIP HALL ② USE ONE FLOW DIVIDER TEE TO ACHIEVE EQUAL DISTRIBUTION INTO TWO SERIES OF DROP BOXES AS SHOWN & FLAGGED ON SITE.

Comments:/Conditions:

INITIAL SITE SKETCH SCALE: 1"=60'

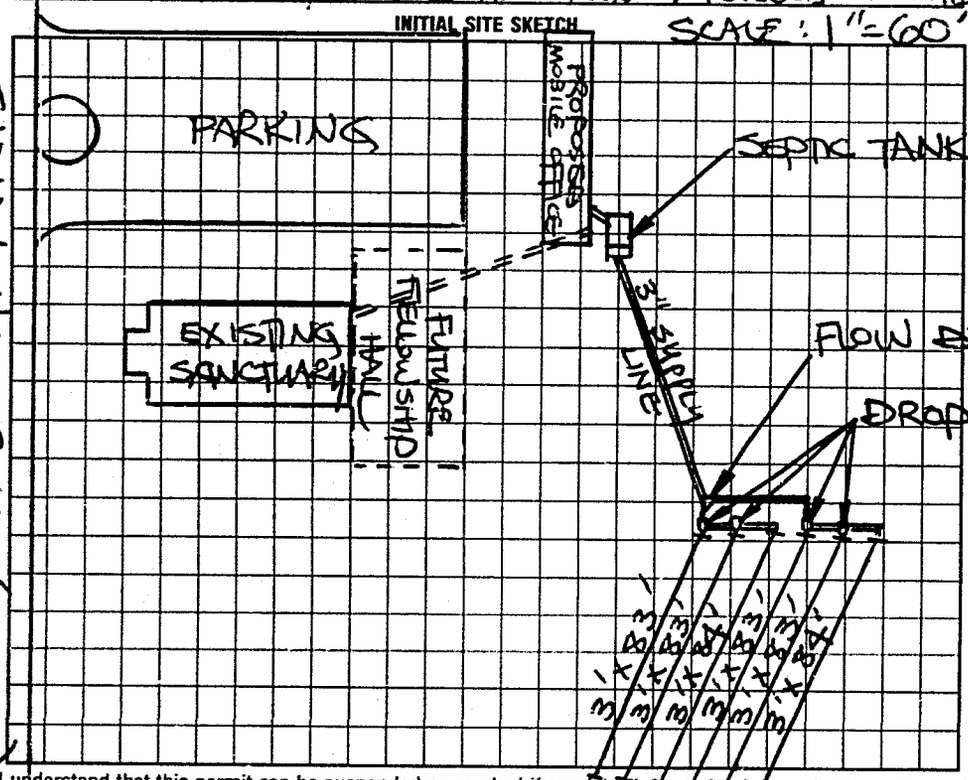

AS BUILT SKETCH

Installed as shown

I understand that this permit can be suspended or revoked if any false information is supplied toward securing the permit/any unauthorized changes are made to the site/any unauthorized changes are made in the installation of the system. Improvement Permit with plat valid without expiration. Improvement Permit with site plan valid for sixty months. Authorization to Construct is valid for a period equal to that of Improvement Permit – not to exceed sixty months.

Signed: X Rev. Steve Pope date 1-2-98
Improvement Permit by: STEVE HEARICK date 1-2-98
Authorization to Construct by: STEVE HEARICK date 1-2-98

Installed by: A-1 Backhoe
Operation Permit by: date
Existing System Inspection by: Mark Collins date 1-9-98

HEALTH DEPT. COPY: WHITE INSPECTION COPY (FINAL): GREEN OWNER COPY (FINAL): YELLOW INSPECTION COPY (INITIAL): PINK OWNER COPY (INITIAL): GOLD