IREDELL COUNTY HEALTH DEPARTMENT

STATESVILLE 704-878-5305 (1) MOORESVILLE 704-664-5281

(1) (1)

IMPROVEMENT PERMIT / AUTHORIZATION TO CONSTRUCT / OPERATION PERMIT / EXISTING SYSTEM INSPECTION

PERMIT# 10747 PIN# 4842-59-9097 DATE 7-10-02

OWNER OR CONTRACTOR WILLIAM & SUSAN REAVIS PHONE: Business Home 704-539-4530

ADDRESS P.O. BOX 35, TURNERSBURG NC, 28688

LOCATION US 21N, TL JENNINGS RD, TR INDIAN HILL ROAD, 0.4 MILE ON RIGHT

SUBDIVISION BLOCK / SECTION LOT LOT AREA 1.0 ACRE SITE CLASS PS DESIGN FLOW 360 L.T.A.R. 0.30 GPD/FT²

Septic Tank: 1000 Gallons: STB 160 Date 5-7-02
Pump Tank: Gallons: PT Date
Pump Make: Model Serial No
Nitrification Field: No. Fields 1 Square Feet 1200 Linear Feet 400
No. Lines FIVE Trench Width 36" Max Trench Bottom Depth 36" Gravel Depth 12"

☑ New System ☐ Repair System Type: I (II) III IV V VI
System Description: CONVENTIONAL, GRAVITY
Repair System Description: CONVENTIONAL, GRAVITY
Maintenance Agreement Required: ☐ Yes ☑ No
☐ Slab ☑ Crawl Space ☐ Basement w/plumbing ☐ Basement wo/plumbing


☐ House/Mod. Home No. Bedrooms 3
☑ Mobile Home No. Bathrooms 2
☐ Business No. Employees
☐ Other

Water Supply: ☐ Individual ☑ Public ☐ Community


Comments/Conditions: INSTALL LINES ON CONTOUR AS SHOWN & FLAGGED ON SITE

Comments/Conditions: ① SYSTEM ALTERED AS SHOWN WITH PRIOR HEALTH DEPT. APPROVAL ② SEPTIC TANK WITH MARKER INSTALLED USING "ZABEL" FILTER

INITIAL SITE SKETCH

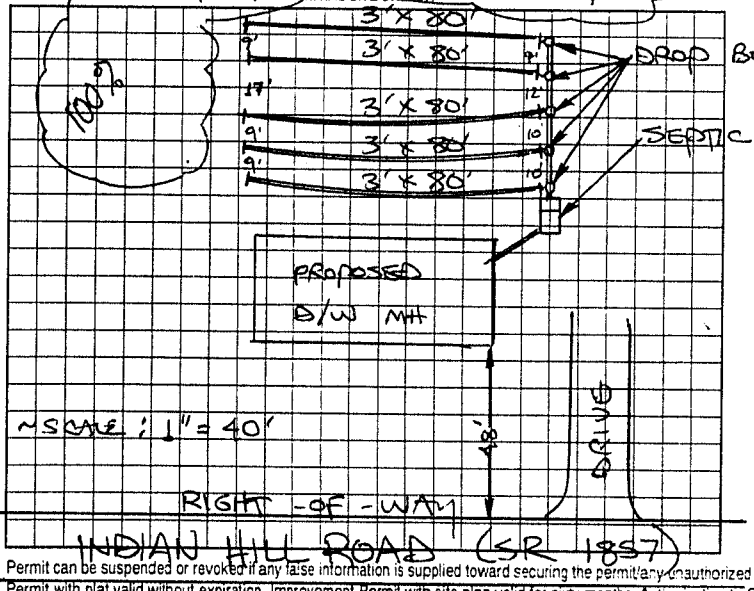

AS BUILT SKETCH

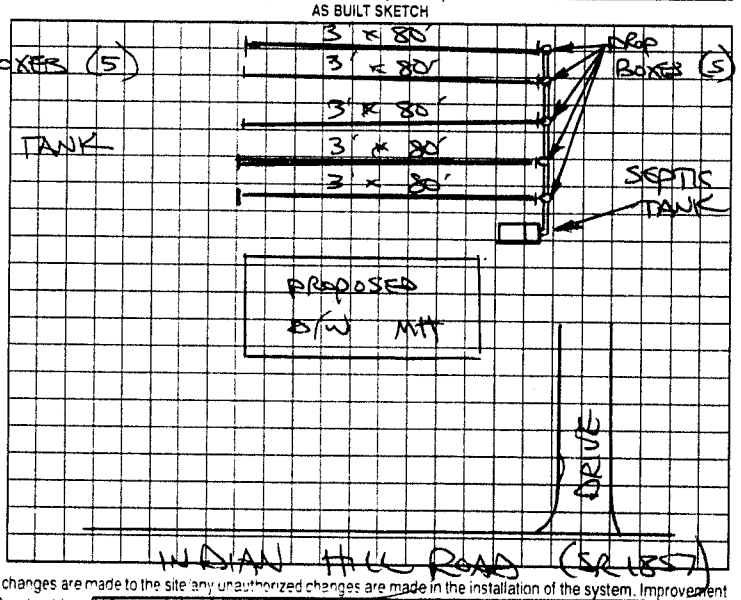

Permit can be suspended or revoked if any false information is supplied toward securing the permit/any unauthorized changes are made to the site/any unauthorized changes are made in the installation of the system. Improvement Permit with plat valid without expiration. Improvement Permit with site plan valid for sixty months. Authorization to Construct is valid for a period equal to that of Improvement Permit – not to exceed sixty months

Signed: William D. Reavis date 7-10-02 Installed by: CARDWELL GRADING

Improvement Permit by: STEVE HEDRICK date 7-10-02 Operation Permit by: STEVE HEDRICK date 7-17-02

Authorization to Construct by: STEVE HEDRICK date 7-10-02 Existing System Inspection by: date

HEALTH DEPT COPY: WHITE OWNER COPY (FINAL): YELLOW OWNER COPY (INITIAL): PINK