IREDELL COUNTY HEALTH DEPARTMENT

STATESVILLE 704-878-5305 MOORESVILLE 704-664-5281

IMPROVEMENT PERMIT / AUTHORIZATION TO CONSTRUCT / OPERATION PERMIT / EXISTING SYSTEM INSPECTION

PERMIT# 123990 PIN# ~~4842-61-7480.1~~ 62-4190 DATE 10-1-04

OWNER OR CONTRACTOR LEE HOOTS PHONE: Business (704) 539-4862 Home

ADDRESS 385 BASSETT RD. OLIN NC 28660

LOCATION I-77N TL TOMLIN MILL TR JENNINGS TR HUIE TL SEMPER FIDELIS PROP ON RT ~ 1/8 MI

SUBDIVISION BLOCK / SECTION LOT LOT AREA 2.184 SITE CLASS. PS DESIGN FLOW 360 L.T.A.R. 0.25 GPD/FT²

Septic Tank: 1000 Gallons; STB 960 Date 5-18-
Pump Tank: Gallons; PT Date
Pump Make: Model Serial No.
Nitrification Field: No Fields 1 Square Feet Linear Feet 480
No Lines 4 Trench Width 36" Max Trench Bottom Depth 36"

☑ New System ☐ Repair System Type: I, II, III, IV, V, VI
System Description: CONVENTIONAL GRAVITY
Repair System Description: LP PANEL 50% RED
Maintenance Agreement Required: ☐ Yes ☑ No

Gravel Depth 12" ☐ Slab ☑ Crawl Space ☐ Basement w/plumbing ☐ Basement wo/plumbing

☑ House/Mod. Home No. Bedrooms 3
☐ Mobile Home No. Bathrooms
☐ Business No. Employees
☐ Other


Water Supply: ☐ Individual ☐ Public ☑ Community

Comments/Conditions: ① INSTALL LINES ON CONTOUR ② PUMP, CRUSH, FILL OLD TANK / REROUTE PLUMBING TO NEW TANK

Comments/Conditions: ① Red Polylok ② #5 stone ③ No riser installed because ST <6" below surface

* 1" = 60'

INITIAL SITE SKETCH

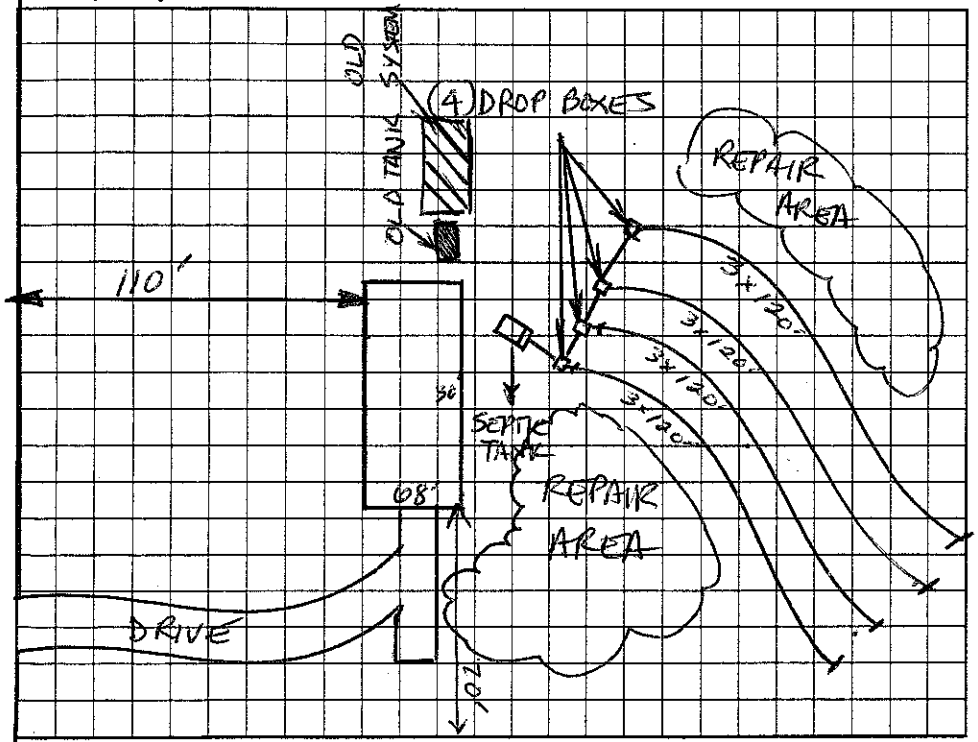

AS BUILT SKETCH

* System installed according to sketch.

SEMPER FIDELIS RD.

Permit can be suspended or revoked if any false information is supplied toward securing the permit/any unauthorized changes are made to the site/any unauthorized changes are made in the installation of the system. Improvement Permit with plat valid without expiration. Improvement Permit with site plan valid for sixty months. Authorization to Construct is valid for a period equal to that of Improvement Permit – not to exceed sixty months.

Signed: Lee Hoots date 16-4-04 Installed by: BRENT GALLIHER

Improvement Permit by: Christopher M. Shuler RS date 10-1-04 Operation Permit by: Christopher M. Shuler RS date 10-11-04

Authorization to Construct by: Christopher M. Shuler RS date 10-4-04 Existing System Inspection by: date

HEALTH DEPT. COPY: WHITE OWNER COPY (FINAL): YELLOW OWNER COPY (INITIAL): PINK