IREDELL COUNTY HEALTH DEPARTMENT

Statesville Office (704) 878-5305 Mooresville Office (704) 660-3625 PERMIT # 201446

IMPROVEMENT PERMIT / AUTHORIZATION TO CONSTRUCT / OPERATION PERMIT / EXISTING SYSTEM

PIN # ~~4842618424~~ 62-6290

APPLICANT: Abee's Clearing + Grading APPLICANT ADDRESS: 2381 US Hwy 64 West

SITE ADDRESS: 242 Semper Fidelis Rd. - Olin 28660 PHONE: 704-239-3693 ALT. PHONE: N/A

SITE DIRECTIONS: Hwy 21 N TL Jennings Rd. TR Hare Rd. TL Semper Fidelis Rd.


SUBDIVISION: N/A SECTION: N/A LOT # N/A LOT AREA: 69.73 acres DESIGN FLOW: 360gpd L.T.A.R.: 0.25

Septic Tank	1000 (gal)	STB	760-1000	Date	9-28	☐ New System ☐ Repair ☐ Expansion	System Type: I II ☑ III IV V VI	☑ Residence	No. Bedrooms 3
Pump Tank	(gal)	PT		Date		System Description:	25% Reduction	☐ Business	No. Persons 6
Pump Make		Model		Serial #		Repair System Description:	25% Reduction	☐ Other	No. Employees
# Nitrification Fields	1	# Lines	3	Linear Ft:	360'	Maintenance Agreement Required:	☐ YES ☑ NO	☐ Slab	☑ Crawl Space
Trench Width	36"	Max. Trench Bottom Depth	28"	Gravel Depth	N/A	☑ GRAVITY	☐ PRESSURE	☐ Basement w/plumbing	☐ Basement w/o plumbing

Water Supply: ☐ Private ☑ Public ☐ Community

Comments / Conditions: Install a 25% Reduction system on contour with serial distribution maximum trench bottom depth is 28" on high side.

INITIAL SITE SKETCH

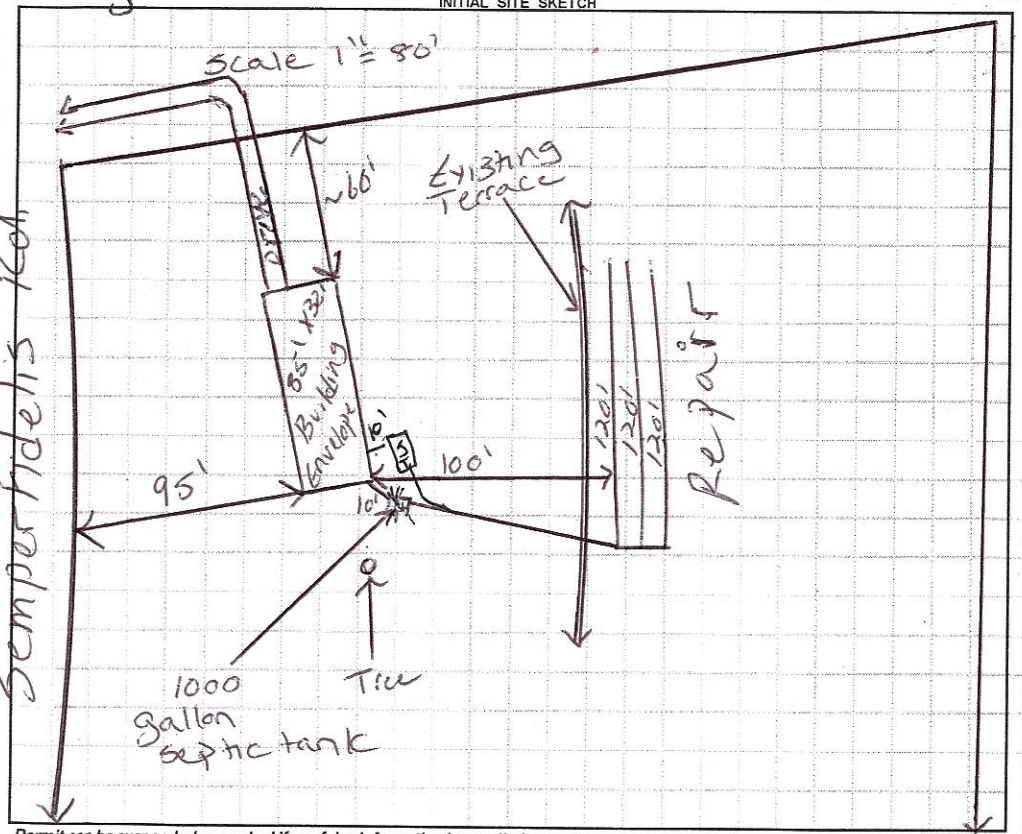

AS BUILT SKETCH

- Red Polylok Filter installed
- Arc36 Chamber installed
- Installed as drawn

Permit can be suspended or revoked if any false information is supplied toward securing the permit / any unauthorized changes are made to the site / any unauthorized changes are made in the installation of the system. **CONTACT A LOCATOR SERVICE PRIOR TO ANY EXCAVATION**

☐ **IMPROVEMENT PERMIT** *with plat valid without expiration.* ☑ **IMPROVEMENT PERMIT** *with site plan valid for 60 mos.* ☑ **AUTHORIZATION TO CONSTRUCT** *valid for period equal to IMPROVEMENT PERMIT--not to exceed 60 mo.*

Owner / Applicant Signature: Deena Abee Date: 2/26/14 Installed by: Abee's Grading

IMPROVEMENT PERMIT by: Justin Henderson Date: 2-24-14 OPERATION PERMIT by: Justin Henderson Date: 3-24-14

AUTHORIZATION TO CONSTRUCT by: Justin Henderson Date: 2-24-14 Existing System Inspected by: Date:

Health Dept. Copy - WHITE Applicant (Final Approval) - YELLOW Applicant (Conditional Approval) - PINK