ICHD - ENVIRONMENTAL HEALTH DIVISION

SB

Statesville Office (704) 878-5305 | Mooresville Office (704) 660-3625

PERMIT # OSWP 2023-30042

SEPTIC: IMPROVEMENT PERMIT / AUTHORIZATION TO CONSTRUCT / OPERATION PERMIT / EXISTING SYSTEM / Repair

PIN # 4842 -- 62 -- 9290

APPLICANT/OWNER: Shane Brayhill

APPLICANT ADDRESS: 1224 N. First St. Winston Salem 27101

SITE ADDRESS: 226 Semper Fidelis Olin 28660

PHONE: 828-3086007

ALT. PHONE

SITE DIRECTIONS: Jennings Rd - @ Bassett - @ Semper Fidelis - Lot on (L)

SAP CONTROLLED: ☐ YES ☐ NO

SUBDIVISION: Sharon Joy Jones

SECTION: 1 LOT # 2 LOT AREA: 2.839

DESIGN FLOW: Ex. L.T.A.R.: Ex


Septic Tank	1000	(gal)	STB	760	Date	5/24/23	☐ New System	☑ Repair	☐ Expansion	System Type: I II III IV V VI	
Pump Tank		(gal)	PT		Date		System Description:				
Pump Make			Model		Serial #		Repair System Description:	Tank Replacement			
# Nitrification Fields	—		# Lines	Ex	Linear Ft	Ex	Maintenance Agreement Required:	☐ YES	☐ NO		
Trench Width	Ex.		Trench Bottom Depth(Low side)	Ex.	Gravel Depth	Ex.		☐ GRAVITY	☐ PRESSURE		

☑ Residence	No. Bedrooms	Ex	**Water Supply**
☐ Business	No. Persons	Ex	☐ Private
☐ Other	No. Employees		☑ Public
☐ Slab	☐ Crawl Space		☐ Community
☐ Basement w/plumbing			☐ Basement w/o plumbing

Comments / Conditions: Pump, crush, & fill existing tank. May move tank location to achieve fall. System appears to be functioning at time of inspection.


Replace distribution device if needed

INITIAL SITE SKETCH

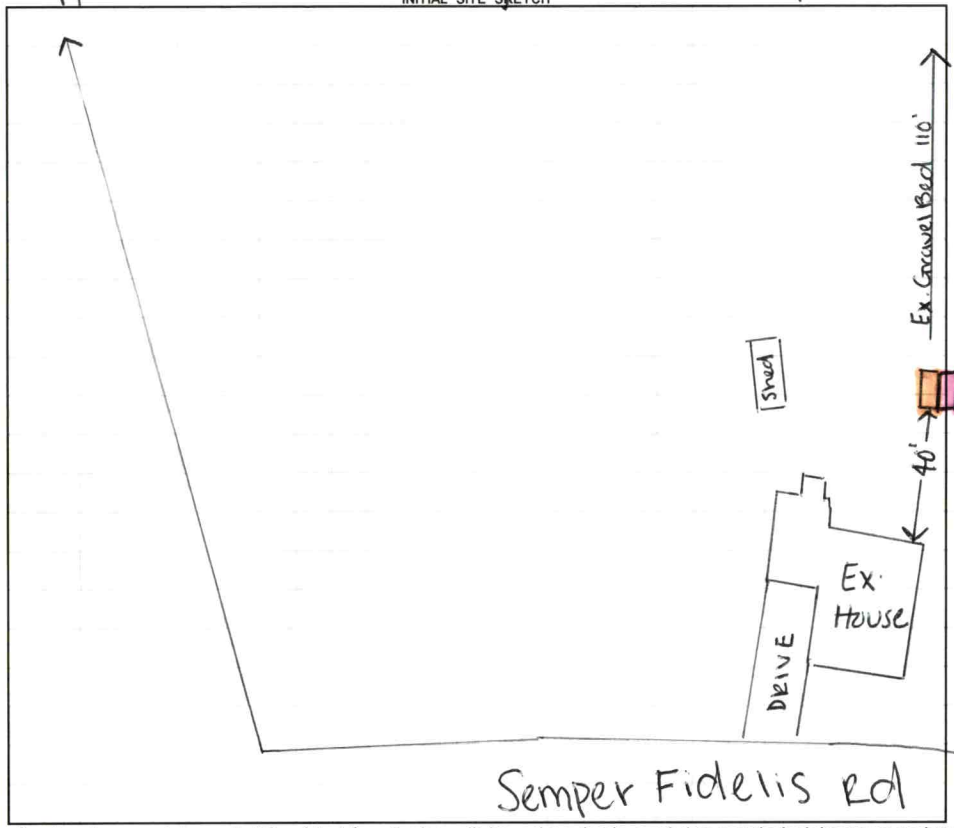

AS BUILT SKETCH

FOR SEPTIC FINAL INSPECTION CALL: 704-664-3703 between 8am-9am the day the inspection is needed. Be sure to speak with an inspector to confirm your time.

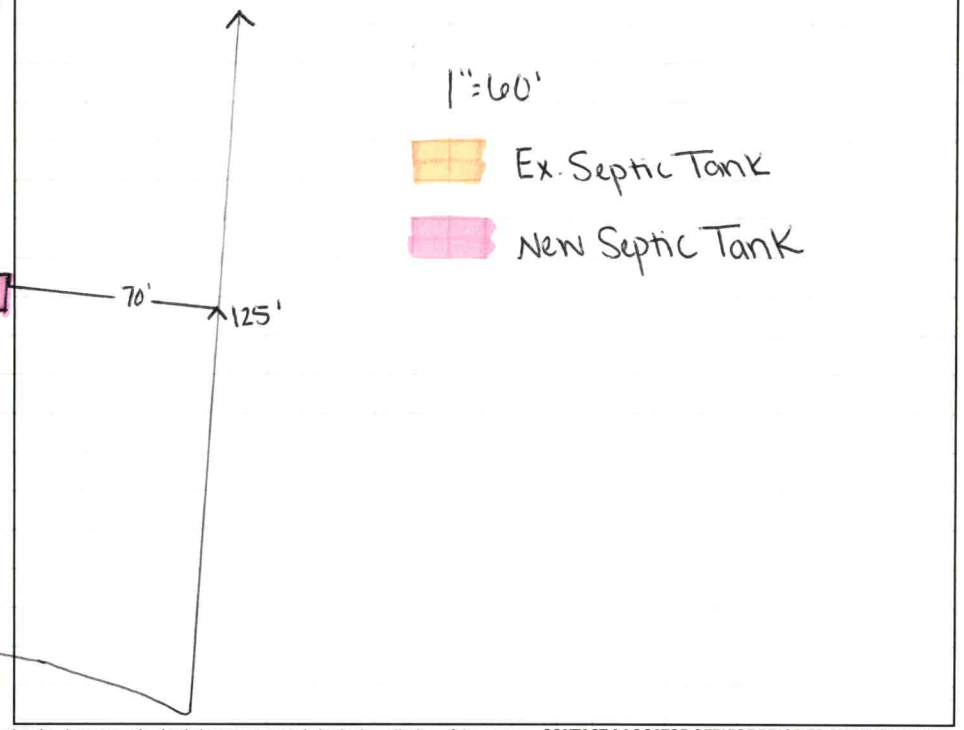

Permit can be suspended or revoked if any false information is supplied toward securing the permit / any unauthorized changes are made to the site / any unauthorized changes are made in the installation of the system. **CONTACT A LOCATOR SERVICE PRIOR TO ANY EXCAVATION**

☐ **IMPROVEMENT PERMIT** *with plat valid without expiration.* ☑ **IMPROVEMENT PERMIT** *with site plan valid for 60 mos.* ☑ **AUTHORIZATION TO CONSTRUCT** *valid for period equal to IMPROVEMENT PERMIT--not to exceed 60 mo.*

Owner / Applicant Signature: online Date:

Installed by: Shane Brayhill

IMPROVEMENT PERMIT by: Sydney Holland Date: 7/18/23

OPERATION PERMIT by: Date: 7/27/23


AUTHORIZATION TO CONSTRUCT by: Sydney Holland Date: 7/18/23

Existing System Inspected by: Date:

FOR SEPTIC FINAL INSPECTION: CALL 704-664-3703 between 8am-9am the day the inspection is needed.

Item	Date	Initials
Drain Lines Checked		
Tanks Checked		
Pressure Manifold or Valve Box Checked		
Pressure Head Set		
Electrical Checked		
Floats Set		
Alarm Checked		
Maintenance Contract Needed? Y / N		
Comments:		

Repairs Only	
	State Code
Failing System Code	
Type of Distribution	G or P
Type of Failure/Malfunction	
Primary Cause of Failure/Malfunction	
Age of System? _____	
Initial or Repair? _____	

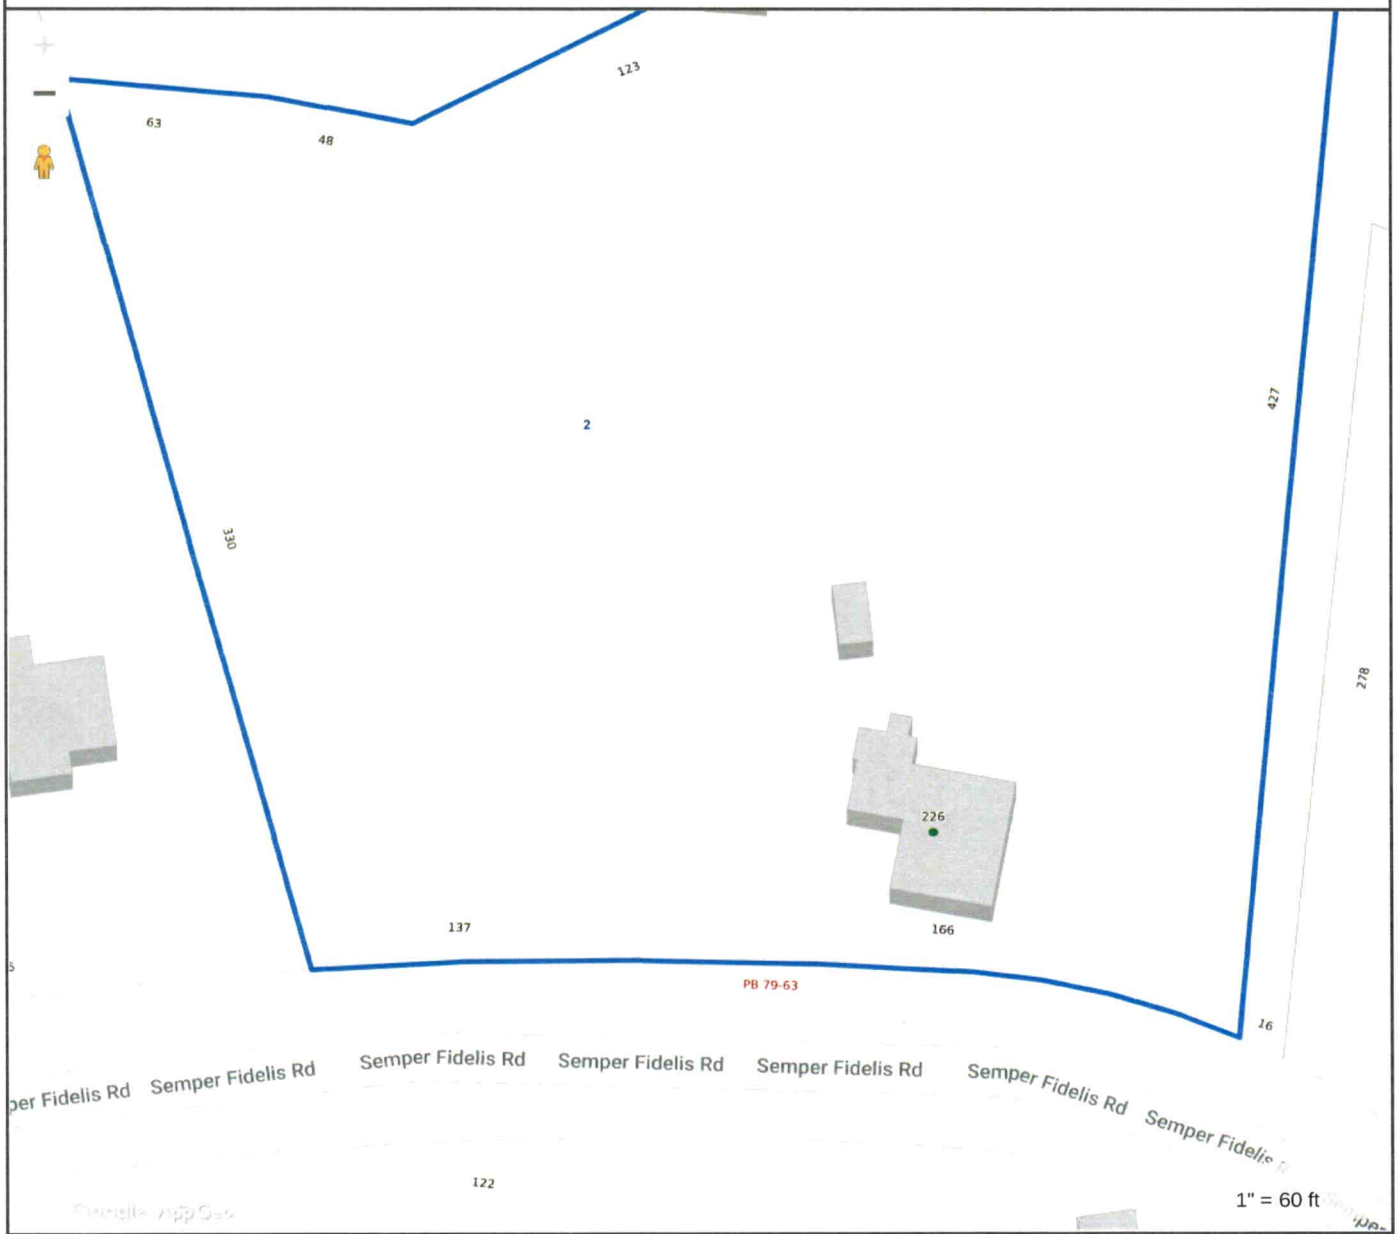

Tax Map Information

• PIN	4842629290.000
• Address	226 SEMPER FIDELIS RD
• Account #	Acct
• Tax Owner	
• Mailing Address	
•	,
• GIS Owner	JONES SHARON J
• Deed Info	2973 / 364 - WD - 20230202
• Tax Acres	2.839
• Lot #	2
• Description	SHARON JOY JONES PB78-59 PB79-63
• Zoning	
• Old Parcel #	
• Bldg Value	$0
• OBXF Value	$0
• Land Value	$0
• Total Value	$0
• Defer Value	$0
• Tax Districts	- -

IREDELL COUNTY NC

MAP FOR REFERENCE ONLY
NOT A LEGAL DOCUMENT

Iredell County, North Carolina makes no claims and no warranties, expressed or implied, concerning the validity or accuracy of the GIS data presented on this map.

Geometry updated 06/05/2023
Data updated 06/05/2023

Print map scale is approximate. Critical layout or measurement activities should not be done using this resource.

Tank SH

226 Semper Fidelis Rd
Olin, NC 28660

