IREDELL COUNTY HEALTH DEPARTMENT

STATESVILLE 704-878-5305 MOORESVILLE 704-664-5281

IMPROVEMENT PERMIT / CERTIFICATE OF COMPLETION / OPERATION PERMIT / EXISTING SYSTEM INSPECTION

PROPERTY DESCRIPTION NO. 18537 DATE 5/20/94 TAX MAP NO. 166-1-A-28 Watershed: ☐ Yes ☒ No

OWNER OR CONTRACTOR FRED [redacted] IRELAND (BOBBY JENNINGS) PHONE: Business 539-4288 Home 539-4491

ADDRESS P.O. BOX 58, UNION GROVE, NC 28689

LOCATION US 21 N, TL JENNINGS RD, T/R INDIAN HILL RD, ON (R) PAST CALVARY BAPTIST CHURCH

SUBDIVISION _____ BLOCK / SECTION _____ LOT _____ LOT AREA 1 1/2 AC SITE CLASS P3 DESIGN FLOW 360 L.T.A.R. EXISTING

Septic Tank: EXISTING Gallons: STB _____ Date _____

Pump Tank: _____ Gallons: PT _____ Date _____

Pump Make: _____ Model _____ Serial No. _____

Nitrification Field: No Fields 1 Square Feet _____ Linear Feet EXISTING

No Lines _____ Trench Width _____ Max Trench Bottom Depth _____ Gravel Depth _____

☒ New System ☐ Repair System Type: I (II) III IV V VI

System Description: CONV. GRAVITY

Repair System Description: CONV. GRAVITY

Maintenance Agreement Required: ☐ Yes ☒ No

☐ House/Mod. Home ☒ Mobile Home ☐ Business ☐ Other

No. Bedrooms 3 No. Bathrooms 2 No. Employees _____

☐ Slab ☒ Crawl Space ☐ Basement w/plumbing ☐ Basement wo/plumbing


Water Supply: ☐ Individual ☐ Community ☒ Public

Comments:

Comments: KEEP MH MINIMUM 5' FROM SEPTIC SYSTEM

INITIAL SITE SKETCH

AS BUILT SKETCH

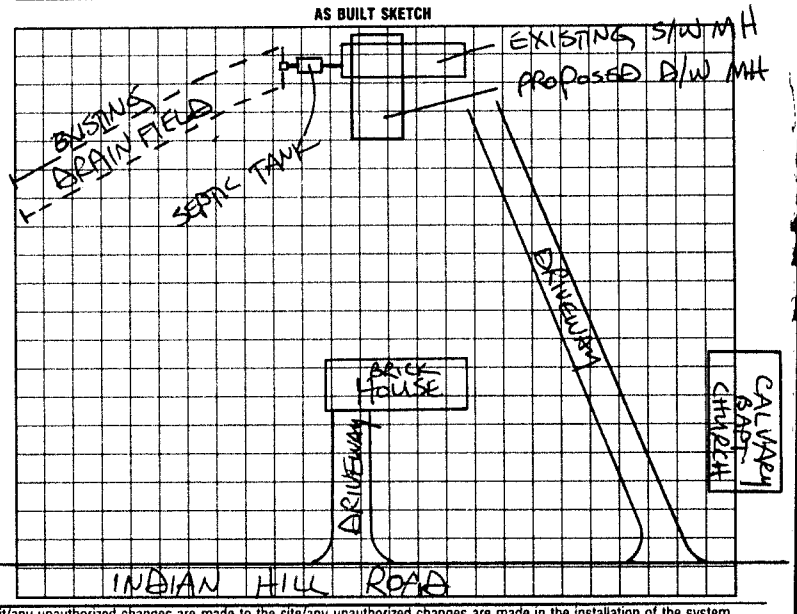

I understand that this permit can be suspended or revoked if any false information is supplied toward securing the permit/any unauthorized changes are made to the site/any unauthorized changes are made in the installation of the system. Improvement Permit is valid for 60 months from date of issuance.

Signed: _____ Installed by: _____

Improvement Permit by: _____ date _____ Certificate of Completion by: _____ date _____

Existing System Inspection by: STEVE HEDRICK date 5/20/94 Operation Permit by: _____ date _____

HEALTH DEPT. COPY: WHITE INSPECTION COPY (FINAL): GREEN OWNER COPY (FINAL): YELLOW INSPECTION COPY (INITIAL): PINK OWNER COPY (INITIAL): GOLD