IREDELL COUNTY HEALTH DEPARTMENT

STATESVILLE 704-878-5305 MOORESVILLE 704-664-5281

IMPROVEMENT PERMIT / CERTIFICATE OF COMPLETION / OPERATION PERMIT / EXISTING SYSTEM INSPECTION

PROPERTY DESCRIPTION NO. REPAIR DATE 11-29-95 TAX MAP NO. Watershed: ☐ Yes ☒ No

OWNER OR CONTRACTOR TOMMY FRYE PHONE: Business Home 539-4915

ADDRESS 287 INDIAN HILL ROAD UNION GROVE NC, 28689

LOCATION US 21 N, TR JENNINGS ROAD, TR INDIAN HILL ROAD ~ 0.5 MILE ON RIGHT

SUBDIVISION BLOCK / SECTION LOT LOT AREA AMPLE SITE CLASS. PS DESIGN FLOW 360 L.T.A.R. EXISTING

Septic Tank: 1000 Gallons; STB 799 Date 8/4/95

Pump Tank: Gallons; PT Date

Pump Make: Model Serial No. 120

Nitrification Field: No Fields 1 Square Feet 720 Linear Feet ~~240~~

No Lines 2 1 Trench Width 6FT Max Trench Bottom Depth 18-36" Gravel Depth 12" ±

☐ New System ☒ Repair System Type: I II III IV V VI

System Description: CONV. GRAVITY

Repair System Description: CONV. GRAVITY

Maintenance Agreement Required: ☐ Yes ☒ No

☐ Slab ☐ Crawl Space ☐ Basement w/plumbing ☒ Basement wo/plumbing

☒ House/Mod. Home No. Bedrooms 3

☐ Mobile Home No. Bathrooms 2

☐ Business No. Employees


☐ Other

Water Supply: ☐ Individual ☐ Community ☒ Public

Comments: ① INSTALL NEW SEPTIC TANK AT LOCATION SHOWN ② USE FLOW DIVIDER TEE TO ACHIEVE EQUAL DISTRIBUTION INTO TWO LINES ③ INSTALL LINES ON CONTOUR MINIMUM 10' FROM WATER LINE

Comments:

INITIAL SITE SKETCH

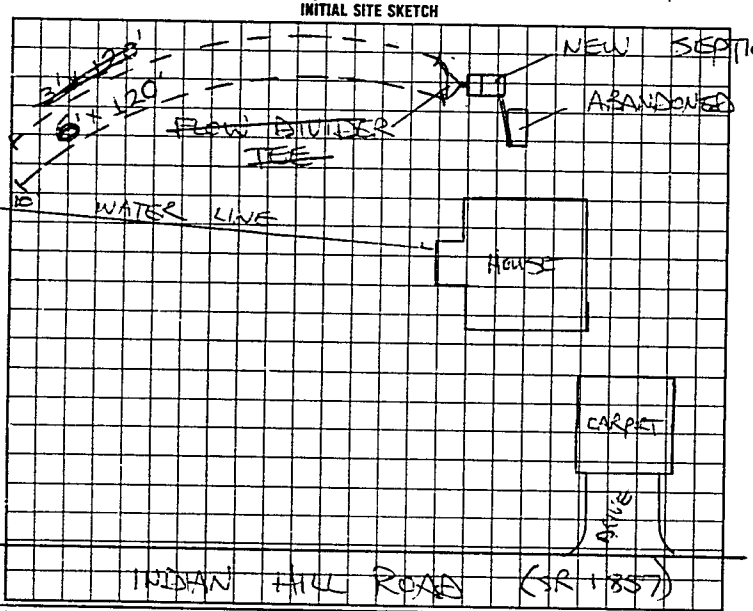

AS BUILT SKETCH

SYSTEM REPAIRED ACCORDING TO REVISED SITE SKETCH

I understand that this permit can be suspended or revoked if any false information is supplied toward securing the permit/any unauthorized changes are made to the site/any unauthorized changes are made in the installation of the system.

Signed: X

AUTHORIZATION TO CONSTRUCT IS VALID FIVE (5) YEARS FROM DATE OF ISSUANCE. IMPROVEMENT PERMIT HAS NO EXPIRATION DATE.

Improvement Permit by: STEVE HEDRICK date 11-29-95

Installed by: A-1 BACKHOE

~~Existing System Inspection~~ AUTHORIZATION TO CONSTRUCT by: STEVE HEDRICK date 11-29-95

~~Certificate of Completion by:~~ date

Operation Permit by: STEVE HEDRICK date 12-4-95

HEALTH DEPT. COPY: WHITE | INSPECTION COPY (FINAL): GREEN | OWNER COPY (FINAL): YELLOW | INSPECTION COPY (INITIAL): PINK | OWNER COPY (INITIAL): GOLD

7920004