IREDELL COUNTY HEALTH DEPARTMENT

STATESVILLE 704-878-5305 MOORESVILLE 704-664-5281

IMPROVEMENT PERMIT / CERTIFICATE OF COMPLETION / OPERATION PERMIT / EXISTING SYSTEM INSPECTION

PROPERTY DESCRIPTION NO. 25544 DATE 12-10-96 TAX MAP NO. 16G-A-39A Watershed: ☐ Yes ☒ No

OWNER OR CONTRACTOR JOSEPH MULLIS PHONE: Business Home 539-5204

ADDRESS 339 BASSETT ROAD, OLIN NC 28660

LOCATION US 21N, TL JENNINGS ROAD, TR BASSETT ROAD 1ST MH ON LEFT PAST ROCKY CREEK

SUBDIVISION — BLOCK / SECTION — LOT — LOT AREA 39.65 AC SITE CLASS. PS DESIGN FLOW 360 L.T.A.R. 0.30 GPD/FT²

Septic Tank: 1000 Gallons; STB 1012 Date 12-6-96

Pump Tank: ____ Gallons; PT ____ Date ____

Pump Make: ____ Model ____ Serial No. ____

Nitrification Field: No Fields 1 Square Feet 1200 Linear Feet 400

No Lines FOUR Trench Width 36" Max Trench Bottom Depth 36" Gravel Depth 12"

☑ New System ☐ Repair System Type: I (II) III, IV, V, VI

System Description: CONVENTIONAL GRAVITY

Repair System Description: CONV. GRAVITY

Maintenance Agreement Required: ☐ Yes ☒ No

☐ House/Mod. Home No. Bedrooms 3

☒ Mobile Home No. Bathrooms 2

☐ Business No. Employees ____

☐ Other FUTURE HOUSE


☐ Slab ☒ Crawl Space ☐ Basement w/plumbing ☐ Basement wo/plumbing

Water Supply: ☐ Individual ☐ Community ☒ Public


Comments: INSTALL LINES ON CONTOUR AS SHOWN, NO DEEPER THAN 36", 9' MINIMUM ON CENTER.

Comments:

INITIAL SITE SKETCH

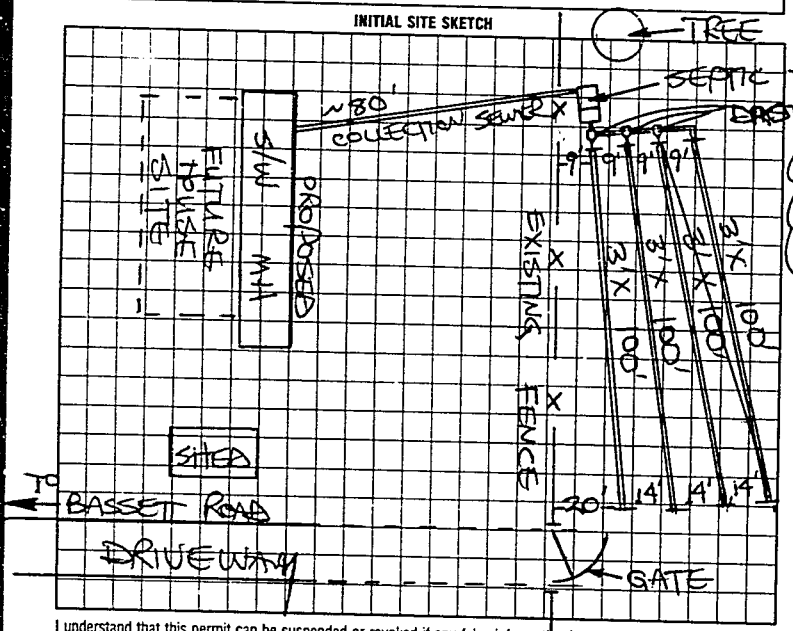

AS BUILT SKETCH

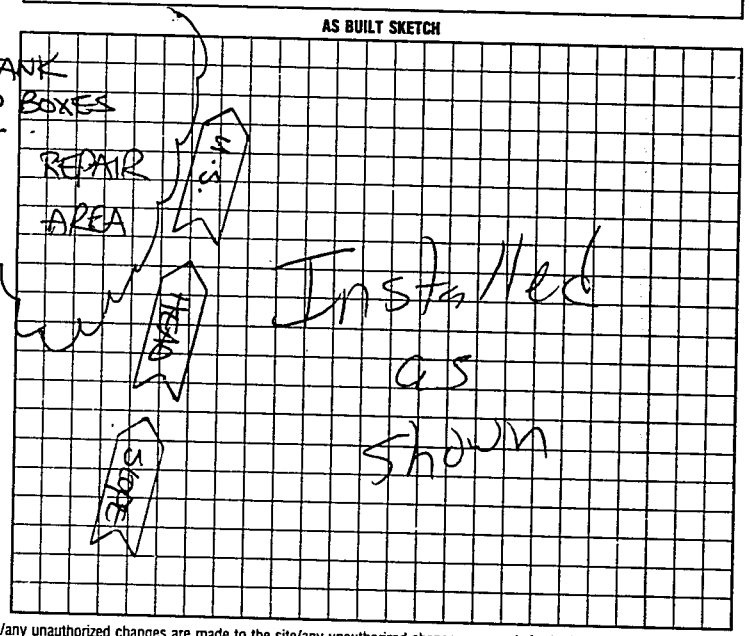

I understand that this permit can be suspended or revoked if any false information is supplied toward securing the permit/any unauthorized changes are made to the site/any unauthorized changes are made in the installation of the system. Improvement Permit is valid for 60 months from date of issuance. AUTH. TO CONST. IS VALID 60 MONTHS.

Signed: Joseph C Mullis

Improvement Permit by: STEVE HEDRICK date 12-10-96

AUTH. TO CONST. Existing System Inspection by: STEVE HEDRICK date 12-10-96

Installed by: A-1 Backhoe

Certificate of Completion by: ____ date ____

Operation Permit by: Mary C Ott ES date 3-26-97

HEALTH DEPT COPY WHITE INSPECTION COPY (FINAL) GREEN OWNER COPY (FINAL) YELLOW INSPECTION COPY (INITIAL) PINK OWNER COPY (INITIAL) GOLD