IREDELL COUNTY HEALTH DEPARTMENT

STATESVILLE 704-878-5305 MOORESVILLE 704-664-5281

IMPROVEMENT PERMIT / AUTHORIZATION TO CONSTRUCT / OPERATION PERMIT / EXISTING SYSTEM INSPECTION

PERMIT# 92225 PIN# 4842 ~~88 2440~~ 789030 DATE 10-3-00

OWNER OR CONTRACTOR Don Pearson PHONE: Business Home 585 6251

ADDRESS PO Box 232 Stoney Point N.C.

LOCATION I-77 N TL 901 TL Sloans Mill TR Indian Hill TL Labrator at end

SUBDIVISION BLOCK / SECTION LOT LOT AREA 22.29 acres SITE CLASS. PS DESIGN FLOW 360 L.T.A.R. .133 gal/sq ft/day

Septic Tank: 1000 Gallons; STB 700 Date 2/1/05
Pump Tank: Gallons; PT Date
Pump Make: Model Serial No.
Nitrification Field: No Fields 1 Square Feet 1080 Linear Feet 360
No Lines 3 Trench Width 36" Max Trench Bottom Depth 36" Gravel Depth 12"

☑ New System ☐ Repair System Type: I, II, III, IV, V, VI
System Description: Conv. Gravity
Repair System Description: " "
Maintenance Agreement Required: ☐ Yes ☑ No

☑ House/Mod. Home No. Bedrooms 3
☐ Mobile Home No. Bathrooms 3
☐ Business No. Employees
☐ Other


☐ Slab ☑ Crawl Space ☑ Basement w/plumbing ☐ Basement wo/plumbing

Water Supply: ☐ Individual ☑ Public ☐ Community


Comments:/Conditions:

Comments:/Conditions: SX W/ RISERS AND RED POLY-LOK FILTER
INSTALLED AS DRAWN

INITIAL SITE SKETCH

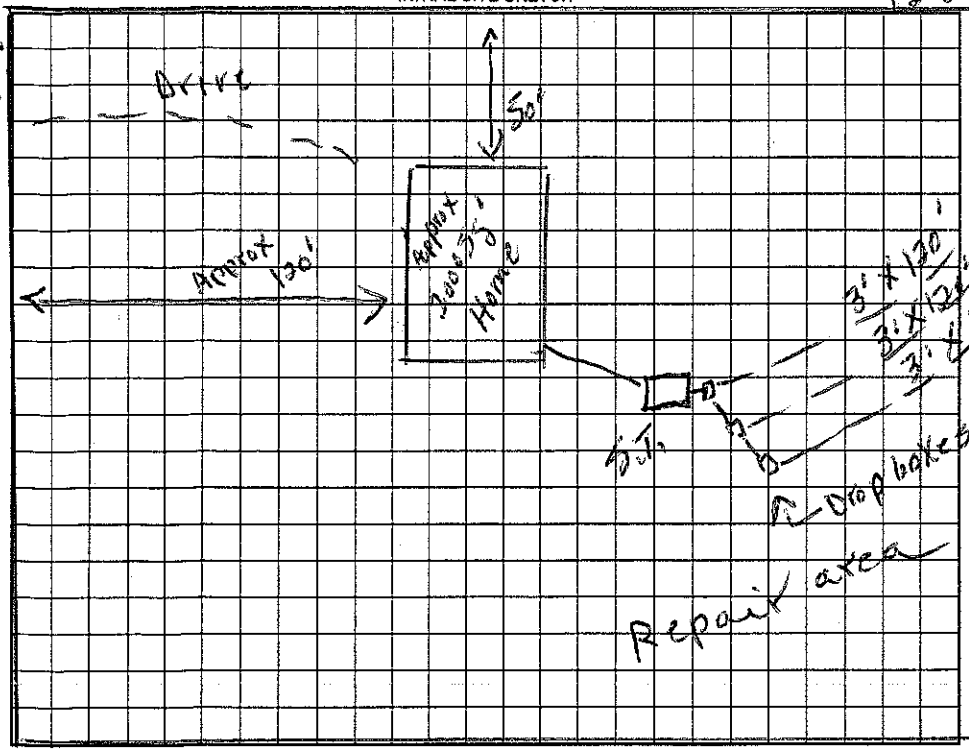

AS BUILT SKETCH

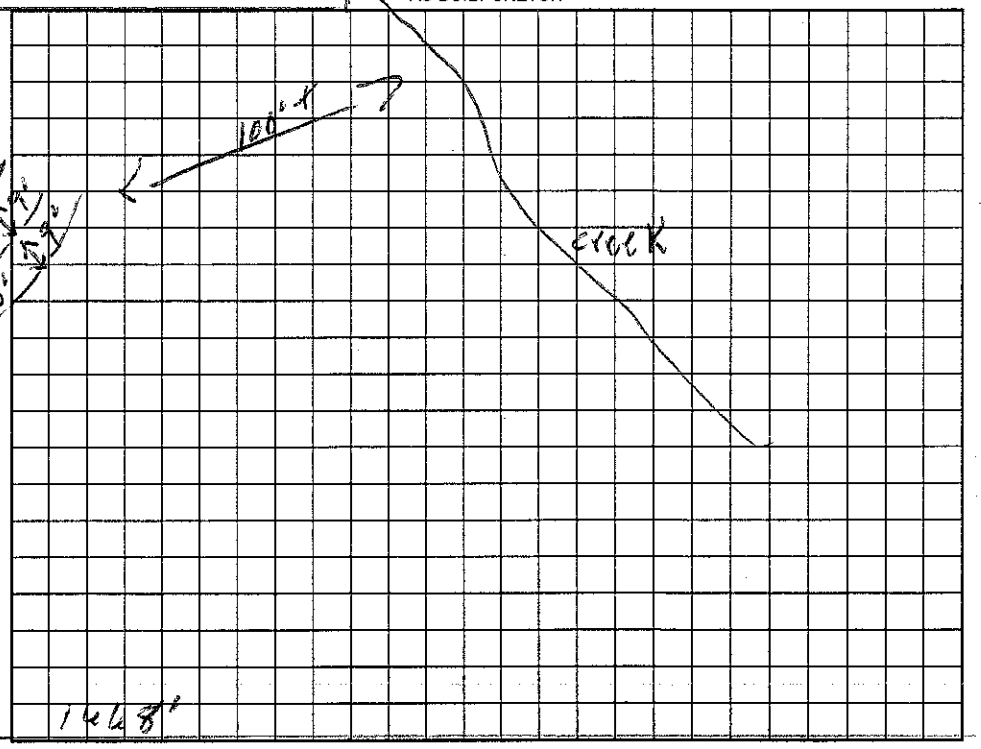

Permit can be suspended or revoked if any false information is supplied toward securing the permit/any unauthorized changes are made to the site/any unauthorized changes are made in the installation of the system. Improvement Permit with plat valid without expiration. Improvement Permit with site plan valid for sixty months. Authorization to Construct is valid for a period equal to that of Improvement Permit – not to exceed sixty months.

Signed: X Don Pearson date 10-3-00 Installed by: BRENT GALLIHER

Improvement Permit by: P.C. Moore date 10-3-00 Operation Permit by: [signature] date 9/30/05

Authorization to Construct by: P.C. Moore date 10-3-00 Existing System Inspection by: date

HEALTH DEPT. COPY: WHITE OWNER COPY (FINAL): YELLOW OWNER COPY (INITIAL): PINK