IREDELL COUNTY HEALTH DEPARTMENT

STATESVILLE 704-878-5305 MOORESVILLE 704-664-5281

IMPROVEMENT PERMIT / CERTIFICATE OF COMPLETION / OPERATION PERMIT / EXISTING SYSTEM INSPECTION

PROPERTY DESCRIPTION NO. 20906 DATE 4/27/95 TAX MAP NO 166-A-87 Watershed: ☐ Yes ☐ No

OWNER OR CONTRACTOR RANDY SIMMERSON PHONE: Business Home 539-4494

ADDRESS 172 LABRADOR DR, UNION GROVE, NC 28689

LOCATION I-77N, TL NC901, TL SLOANS MILL RD, TR INDIAN HILL, TL LABRADOR, 1ST MH ON RIGHT.

SUBDIVISION BLOCK / SECTION LOT LOT AREA 9.28 AC SITE CLASS PS DESIGN FLOW 240 L.T.A.R. 0.33 GPD/FT²

Septic Tank: 1000 Gallons; STB 1012 Date 3/6/95

Pump Tank: Gallons; PT Date

Pump Make: Model Serial No.

Nitrification Field: No Fields 3 Square Feet 720 Linear Feet 240

No Lines 3 Trench Width 36" Max Trench Bottom Depth 18-36" Gravel Depth

☑ New System ☐ Repair System Type: I II III IV V VI

System Description: CONVENTIONAL GRAVITY

Repair System Description: CONV. GRAVITY

Maintenance Agreement Required: ☐ Yes ☑ No

☐ House/Mod. Home No. Bedrooms 2

☑ Mobile Home No. Bathrooms 2

☐ Business No. Employees

☐ Other


☐ Slab ☑ Crawl Space ☐ Basement w/plumbing ☐ Basement wo/plumbing

Water Supply: ☐ Individual ☐ Community ☑ Public

Comments:

Comments:

INITIAL SITE SKETCH

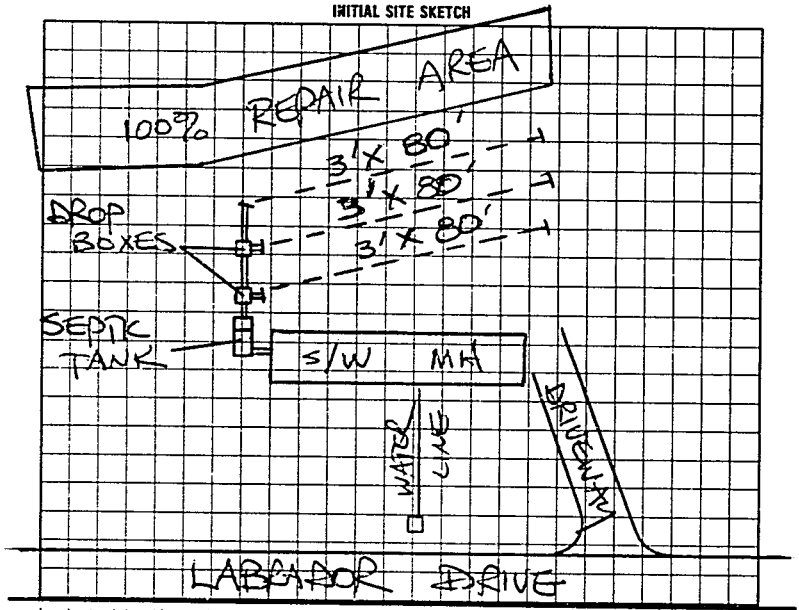

AS BUILT SKETCH

SYSTEM INSTALLED ACCORDING TO INITIAL SITE SKETCH

I understand that this permit can be suspended or revoked if any false information is supplied toward securing the permit/any unauthorized changes are made to the site/any unauthorized changes are made in the installation of the system. Improvement Permit is valid for 60 months from date of issuance.

Signed: X Randy Simmerson

Improvement Permit by: STEVE HEDRICK date 4/27/95

Existing System Inspection by: date

Installed by: TOMMY FRYE

Certificate of Completion by: STEVE HEDRICK date 6/13/95

Operation Permit by: date

HEALTH DEPT COPY WHITE INSPECTION COPY (FINAL) GREEN OWNER COPY (FINAL) YELLOW INSPECTION COPY (INITIAL) PINK OWNER COPY (INITIAL) GOLD

87100