IREDELL COUNTY HEALTH DEPARTMENT

STATESVILLE 704-878-5305 MOORESVILLE 704-664-5281

56523

IMPROVEMENT PERMIT / CERTIFICATE OF COMPLETION / OPERATION PERMIT / EXISTING SYSTEM INSPECTION

PROPERTY DESCRIPTION NO. 21403 DATE 6-22-95 TAX MAP NO. 16G - A - 87 (PART) Watershed: ☐ Yes ☑ No

OWNER OR CONTRACTOR RANDY SIMMERSON PHONE: Business

ADDRESS 172 LABRADOR DRIVE, UNION GROVE, NC 28689 Home 539-4494

LOCATION I-77 N, TL NC 901, TL SLOANS MILL RD, TR INDIAN HILL RD, TL LABRADOR DR,

SUBDIVISION BLOCK / SECTION LOT LOT AREA 9.28 AC SITE CLASS PS DESIGN FLOW 360' L.T.A.R. 0.33 GPD/FT²

Septic Tank: 1000 Gallons; STB ~~1000~~ Date

Pump Tank: Gallons; PT 358 Date

Pump Make: Model Serial No.

Nitrification Field: No Fields 1 Square Feet 1080 Linear Feet 360

No Lines 3 Trench Width 36" Max Trench Bottom Depth 18-24" Gravel Depth 12"

☑ New System ☐ Repair System Type: I, II, III, IV, V, VI

System Description: CONVENTIONAL GRAVITY

Repair System Description: CONV. GRAVITY

Maintenance Agreement Required: ☐ Yes ☑ No

☐ Slab ☐ Crawl Space ☑ Basement w/plumbing ☐ Basement wo/plumbing

☑ House/Mod. Home No. Bedrooms 3

☐ Mobile Home No. Bathrooms 3

☐ Business No. Employees

☐ Other


Water Supply: ☐ Individual ☐ Community ☑ Public

Comments: KEEP SYSTEM MINIMUM 15' FROM BASEMENT FOUNDATION DRAIN @ INSTALL LINES NO DEEPER THAN 24".

Comments:

2ND DRIVEWAY ON RIGHT

INITIAL SITE SKETCH

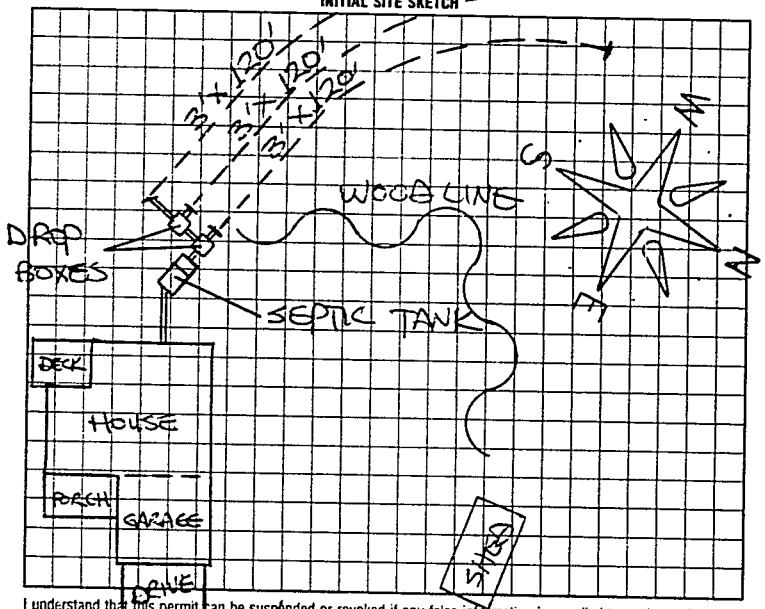

AS BUILT SKETCH

SYSTEM INSTALLED ACCORDING TO INITIAL SITE SKETCH

I understand that this permit can be suspended or revoked if any false information is supplied toward securing the permit/any unauthorized changes are made to the site/any unauthorized changes are made in the installation of the system. Improvement Permit is valid for 60 months from date of issuance.

Signed: X Randy Simmerson

Improvement Permit by: STEVE HEDRICK date 6-22-95

Existing System Inspection by: date

Installed by: Tommy FRYE

Certificate of Completion by: date

Operation Permit by: STEVE HEDRICK date 10-15-96

HEALTH DEPT COPY: WHITE INSPECTION COPY (FINAL) GREEN OWNER COPY (FINAL) YELLOW INSPECTION COPY (INITIAL) PINK OWNER COPY (INITIAL) GOLD