IREDELL COUNTY HEALTH DEPARTMENT

STATESVILLE 704-878-5305 MOORESVILLE 704-664-5281

CI

IMPROVEMENT PERMIT / AUTHORIZATION TO CONSTRUCT / OPERATION PERMIT / EXISTING SYSTEM INSPECTION

PERMIT# 108992 PIN# 4842-79-6763 (PART of 4842.89.1713 PART of) DATE 10-4-02

OWNER OR CONTRACTOR FLEETWOOD HOMES of STVL PHONE Business Home 704-872-0179

ADDRESS 1270 NORTHSIDE DR, STATESVILLE, NC 28677

LOCATION US 21 N, TL JENNINGS RD, TR INDIAN HILL RD, TR LABRADOR DRIVE, 225' ON LEFT

SUBDIVISION BLOCK / SECTION LOT LOT AREA 0.9999 ACRE SITE CLASS P3 DESIGN FLOW 360 L.T.A.R. 0.25 GPD/FT²

Septic Tank: 1000 Gallons: STB 1012 Date 4-1-02
Pump Tank: Gallons: PT Date
Pump Make: Model Serial No
Nitrification Field: No Fields ↓ Square Feet 1940 Linear Feet 240
No Lines SIX Trench Width 24" Max Trench Bottom Depth 36" Gravel Depth SAND 6"

☑ New System ☐ Repair System Type: I. II (III) IV. V. VI
System Description: 50% REDUCTION GRAVITY
Repair System Description: 50% REDUCTION, LOW
Maintenance Agreement Required: ☐ Yes ☑ No PRESSURE
☐ Slab ☑ Crawl Space ☐ Basement w/plumbing ☐ Basement wo/plumbing


☐ House/Mod. Home No. Bedrooms 3
☑ Mobile Home No. Bathrooms 2
☐ Business No. Employees
☐ Other

Water Supply: ☐ Individual ☑ Public ☐ Community

Comments/Conditions: INSTALL 50% REDUCTION SYSTEM USING FIFTY-FOUR (54) PPBPS PANELS IN SIX EQUAL LENGTH LINES ON CONTOUR

Comments/Conditions: TUFFTITE FILTER & MARKER

INITIAL SITE SKETCH

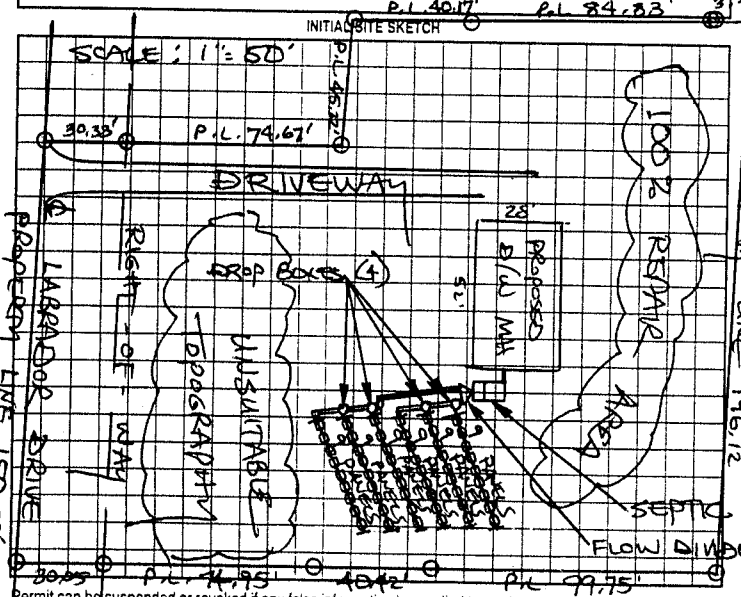

AS BUILT SKETCH

INSTALLED AS DRAWN

Permit can be suspended or revoked if any false information is supplied toward securing the permit/any unauthorized changes are made to the site/any unauthorized changes are made in the installation of the system. Improvement Permit with plat valid without expiration. Improvement Permit with site plan valid for sixty months. Authorization to Construct is valid for a period equal to that of Improvement Permit – not to exceed sixty months

Signed: date 10-4-02 Installed by: CRAIG THOMPSON

Improvement Permit by: STEVE HEDRICK date 10-4-02 Operation Permit by: date 10-10-02

Authorization to Construct by: STEVE HEDRICK date 10-4-02 Existing System Inspection by: date

HEALTH DEPT COPY: WHITE OWNER COPY (FINAL): YELLOW OWNER COPY (INITIAL): PINK