IREDELL COUNTY HEALTH DEPARTMENT

STATESVILLE 704-878-5305 MOORESVILLE 704-664-5281

IMPROVEMENT PERMIT / AUTHORIZATION TO CONSTRUCT / OPERATION PERMIT / EXISTING SYSTEM INSPECTION

PERMIT# 102234 PIN# 4842 95 1244

OWNER OR CONTRACTOR LETTIE S. HOOTS PHONE: Business Home (704) 539-5188 DATE 9-8-01

ADDRESS 362 BASSETT ROAD, OLIN NC 28660

LOCATION I-77 N, TL NC 901, TL SLOANS MILL RD, TR BASSETT RD 0.5 MILE ON LEFT

SUBDIVISION BLOCK / SECTION LOT LOT AREA 6.05 ACRES SITE CLASS PS DESIGN FLOW 240 L.T.A.R. EXISTING 0.4

Septic Tank: 1000 Gallons: STB Date

Pump Tank: Gallons: PT Date

Pump Make: Model Serial No.

Nitrification Field: No Fields 1 Square Feet 600 Linear Feet 200

No Lines TWO Trench Width Max Trench Bottom Depth Gravel Depth 10"

☐ New System ☐ Repair System Type: I (II) III IV V VI

System Description: CONVENTIONAL GRAVITY

Repair System Description:

Maintenance Agreement Required: ☐ Yes ☐ No

☐ Slab ☒ Crawl Space ☐ Basement w/plumbing ☐ Basement wo/plumbing

☐ House/Mod. Home ☒ Mobile Home ☐ Business ☐ Other

No. Bedrooms 2 No. Bathrooms 2 No. Employees


Water Supply: ☐ Individual ☒ Public ☐ Community

Comments/Conditions:

Comments/Conditions: (1) SYSTEM SIZED FOR 2 BEDROOMS ONLY (2) SYSTEM UNDERSIZED ACCORDING TO TODAY'S STANDARDS

INITIAL SITE SKETCH

AS BUILT SKETCH

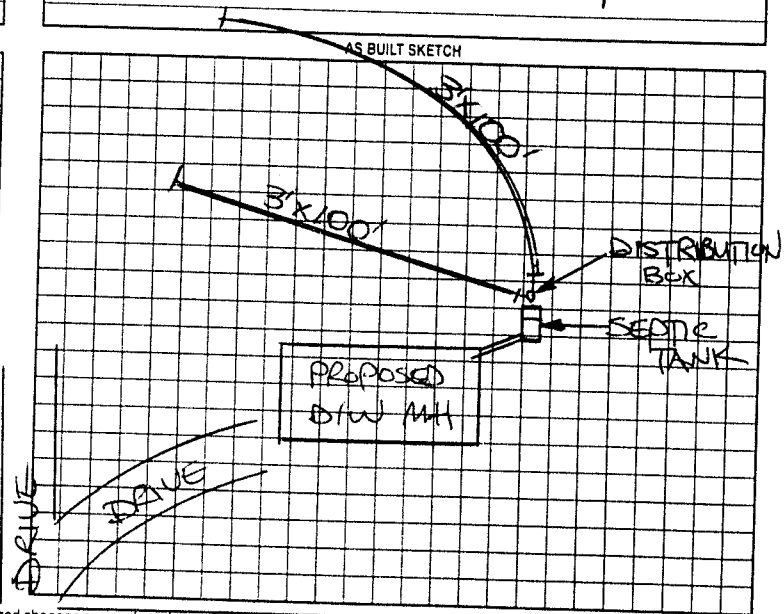

Permit can be suspended or revoked if any false information is supplied toward securing the permit/any unauthorized changes are made to the site/any unauthorized changes are made in the installation of the system. Improvement Permit with plat valid without expiration. Improvement Permit with site plan valid for sixty months. Authorization to Construct is valid for a period equal to that of Improvement Permit – not to exceed sixty months.

Signed: date

Improvement Permit by: date

Authorization to Construct by: date

Installed by: BASSETT ROAD SR 1811

Operation Permit by: date

Existing System Inspection by: STEVE HEDRICK date 9-8-01

HEALTH DEPT. COPY WHITE OWNER COPY (FINAL) YELLOW OWNER COPY (INITIAL) PINK