IREDELL COUNTY HEALTH DEPARTMENT 6/18/93

STATESVILLE 704-878-5305 MOORESVILLE 704-664-5281

IMPROVEMENT PERMIT / CERTIFICATE OF COMPLETION / OPERATION PERMIT / EXISTING SYSTEM INSPECTION

PROPERTY DESCRIPTION NO. 16226 DATE [redacted] TAX MAP NO.

OWNER OR CONTRACTOR HERMAN E. ANDERSON PHONE: Business Home

ADDRESS

LOCATION I-77N, TL NC 901 W, TL SLOAN MILL ROAD ~0.5 MILE ON (R) BEHIND ANDERSON

SUBDIVISION BLOCK / SECTION LOT LOT AREA SITE CLASS. L.T.A.R.

Water Supply: ~~Individual~~ ☐ Community ☑ Public

Septic Tank: 1000 Gallons; STB 782 Date 4/21/93

Pump Tank: Gallons; PT Date

Nitrification Field: No Fields 1 Square Feet 1035 Linear Feet 345

No. Lines 3 Trench Width 36" Trench Depth ≤36" Gravel Depth 12"

☑ New System ☐ Repair System Type: I. II. III. IV. V. VI

System Description: CONV, GRAVITY

Repair System Description: CONV, GRAVITY

Maintenance Agreement Required: ☐ Yes ☑ No

☐ House/Mod. Home ☐ Mobile Home ☐ Business ☐ Other

No. Bedrooms 3 No. Bathrooms 2 No. Employees

☐ Slab ☑ Crawl Space ☐ Basement w/plumbing ☐ Basement wo/plumbing

Garbage Disposal: ☐ Yes ☑ No

Auto. Dishwasher: ☑ Yes ☐ No

Auto. Washing Machine: ☑ Yes ☐ No


Other

ELECTRIC

Comments

INITIAL SITE SKETCH

AS BUILT SKETCH

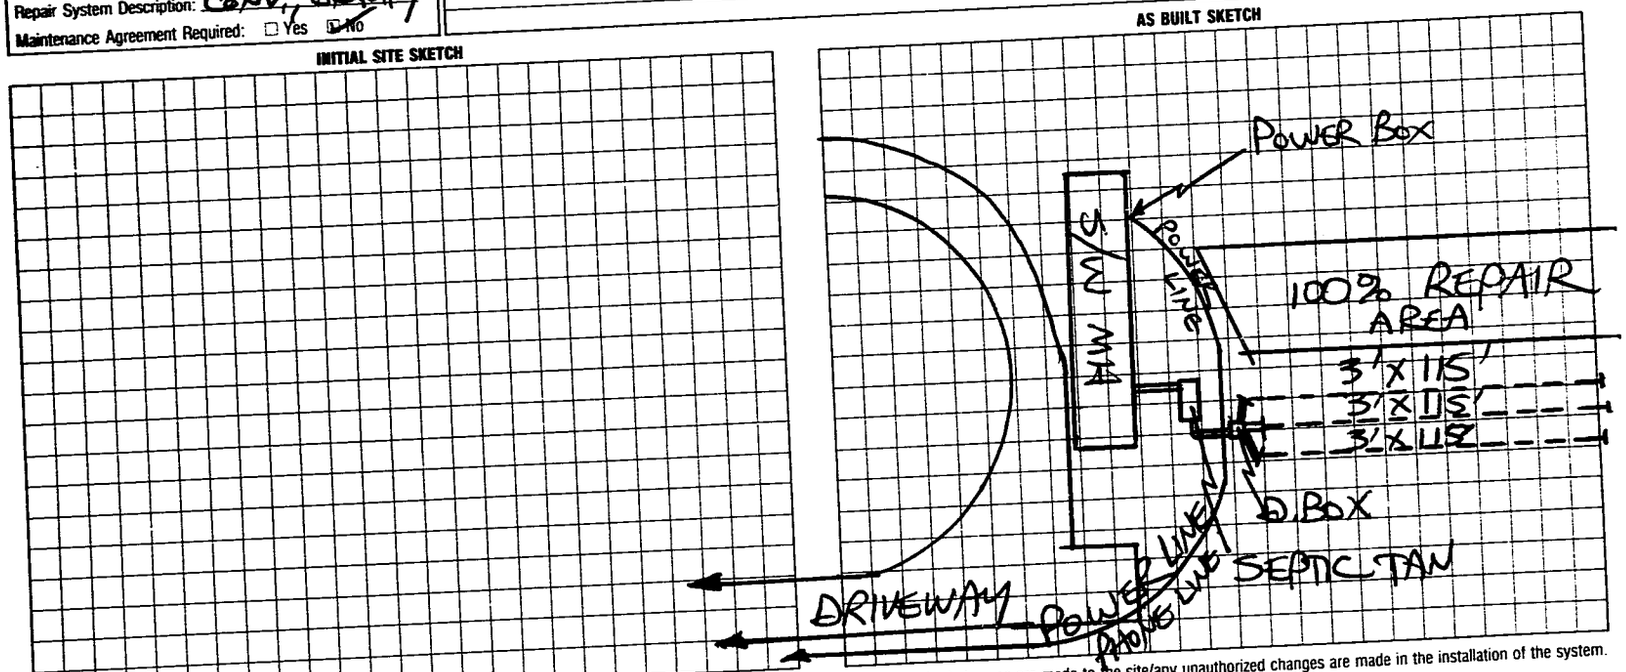

I understand that this permit can be suspended or revoked if any false information is supplied toward securing the permit/any unauthorized changes are made to the site/any unauthorized changes are made in the installation of the system. Improvement Permit is valid for 60 months from date of issuance.

Signed:

Improvement Permit by: STEVE HEDRICK date 4/21/93

Existing System Inspection by: date

Installed by: SAMMY REAVIS

Certificate of Completion by: STEVE HEDRICK date 6/18/93

Operation Permit by: date

HEALTH DEPT. COPY: WHITE INSPECTION COPY (FINAL): GREEN OWNER COPY (FINAL): YELLOW INSPECTION COPY (INITIAL): PINK OWNER COPY (INITIAL): GOLD