IREDELL COUNTY HEALTH DEPARTMENT

STATESVILLE 704-878-5305 MOORESVILLE 704-664-5281

IMPROVEMENT PERMIT / CERTIFICATE OF COMPLETION / OPERATION PERMIT / EXISTING SYSTEM INSPECTION

PROPERTY DESCRIPTION NO 22695 DATE 4-10-96 TAX MAP NO 16H-A-136 Watershed: ☐ Yes ☒ No

OWNER OR CONTRACTOR DWAYNE DOBSON PHONE: Business Home 539-4539

ADDRESS 1213 SLOAN'S MILL ROAD, UNION GROVE, NC 28689

LOCATION I-77 N, TL ~~EXIT~~ NC901 N, TL SLOAN'S MILL RD, ON (R) ~ 0.75 MILE (BEHIND ANDERSON EGG)

SUBDIVISION BLOCK / SECTION LOT LOT AREA 2.60 ACRES SITE CLASS. PS DESIGN FLOW 360 L.T.A.R. 0.30 GPD/FT²

Septic Tank: 1000 Gallons; STB 3-24-97 Date 620

Pump Tank: Gallons; PT Date

Pump Make: Model Serial No.

Nitrification Field: No Fields 1 Square Feet 1200 Linear Feet 400

No Lines 4 Trench Width 36" Max Trench Bottom Depth 18-36" Gravel Depth 12"

☒ New System ☐ Repair System Type: I, II, III, IV, V, VI

System Description: CONVENTIONAL GRAVITY

Repair System Description: CONVENTIONAL PUMP

Maintenance Agreement Required: ☐ Yes ☐ No

☒ House/Mod. Home No. Bedrooms 3

☐ Mobile Home No. Bathrooms 3½

☐ Business No. Employees

☐ Other


☐ Slab ☐ Crawl Space ☒ Basement w/plumbing ☐ Basement wo/plumbing

Water Supply: ☐ Individual ☐ Community ☐ Public


Comments: ① ABANDON EXISTING SEPTIC SYSTEM ② USE THREE FLOW DIVIDER TEES TO ACHIEVE EQUAL DISTRIBUTION INTO EACH OF FOUR 100' LINES ③ KEEP SYSTEM MINIMUM 10' FROM PROPERTY LINE, 15' FROM BASEMENT FOUNDATION DRAIN, 100' FROM ANY WELL

Comments:

INITIAL SITE SKETCH

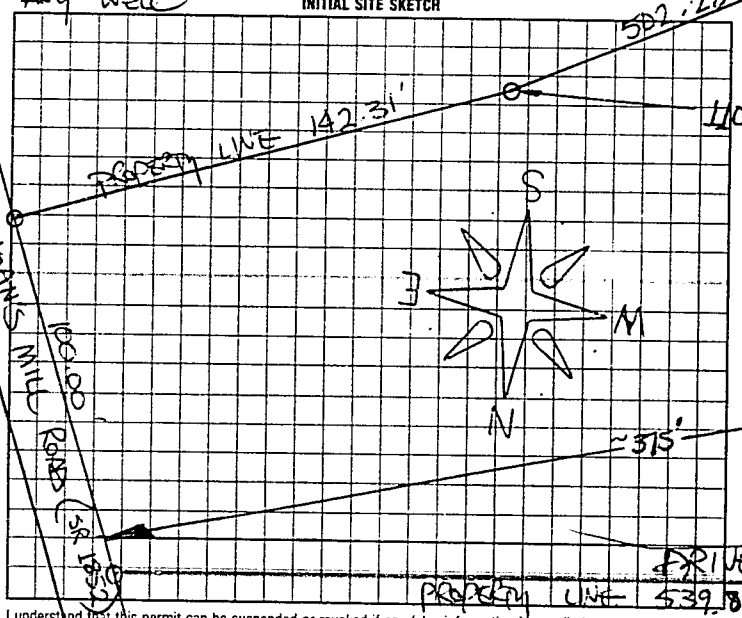

AS BUILT SKETCH

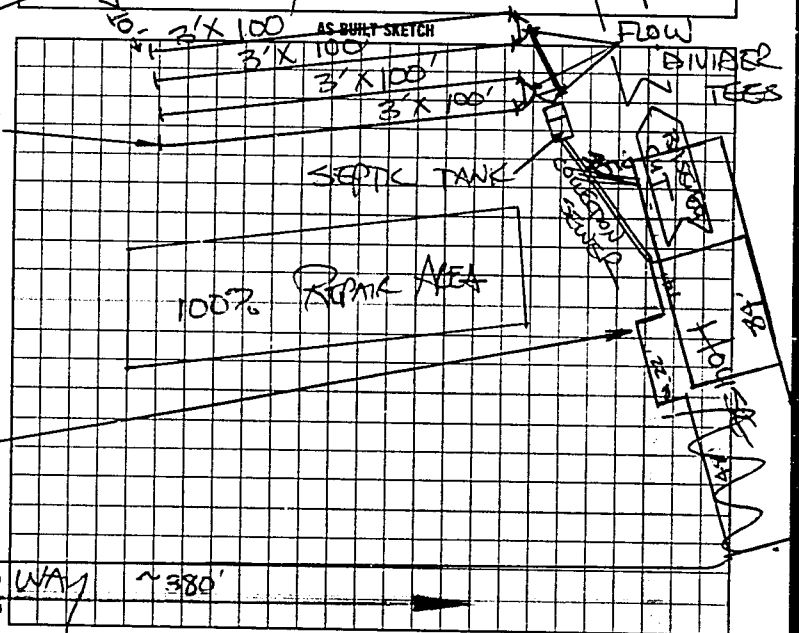

I understand that this permit can be suspended or revoked if any false information is supplied toward securing the permit/any unauthorized changes are made to the site/any unauthorized changes are made in the installation of the system. AUTHORIZATION TO CONSTRUCT IS VALID FIVE (5) YEARS FROM DATE OF ISSUANCE. IMPROVEMENT PERMIT HAS NO EXPIRATION DATE.

Signed: X

Improvement Permit by: STEVE HEDRICK date 4-10-96

~~Existing System Inspection~~ Authorization to Construct by: STEVE HEDRICK date 4-10-96

Installed by: JUNIOR DOBSON

Certificate of Completion by: date

Operation Permit by STEVE HEDRICK date 5-30-97

HEALTH DEPT. COPY: WHITE INSPECTION COPY (FINAL): GREEN OWNER COPY (FINAL): YELLOW INSPECTION COPY (INITIAL): PINK OWNER COPY (INITIAL): GOLD