# IREDELL COUNTY HEALTH DEPARTMENT

STATESVILLE 704-878-5305 MOORESVILLE 704-664-5281

## IMPROVEMENT PERMIT / AUTHORIZATION TO CONSTRUCT / OPERATION PERMIT / EXISTING SYSTEM INSPECTION

PERMIT# 089473 PIN# 4843028509 DATE June 3, 2000

OWNER OR CONTRACTOR Jo Ann Holland PHONE: Business 876-1772 Home

ADDRESS 184 Jennings Road Statesville 28625

LOCATION 2 N. TL Jennings Rd. TL Indian Hill Rd. w/1 miles on Right

SUBDIVISION BLOCK / SECTION LOT LOT AREA 2 Ac SITE CLASS PS DESIGN FLOW 240gpd L.T.A.R. .3

Septic Tank: 1000 Gallons: STB 794 Date 12-14-01

Pump Tank: Gallons: PT Date

Pump Make: Model Serial No

Nitrification Field: No Fields 1 Square Feet 810 Linear Feet 270

No Lines 2+ Trench Width 36" Max Trench Bottom Depth 36" Gravel Depth 12"

☑ New System ☐ Repair System Type: I II III IV V VI

System Description: Gravity Conventional

Repair System Description: SAME

Maintenance Agreement Required: ☐ Yes ☑ No

☑ House/Mod. Home No. Bedrooms 2

☐ Mobile Home No. Bathrooms 2

☐ Business No. Employees

☐ Other


☐ Slab ☑ Crawl Space ☐ Basement w/plumbing ☐ Basement wo/plumbing

Water Supply: ☑ Individual ☐ Public ☐ Community

Comments/Conditions:

Comments/Conditions SEPTIC TANK WITH RISERS INSTALLED USING "ZABEL" FILTER

INITIAL SITE SKETCH

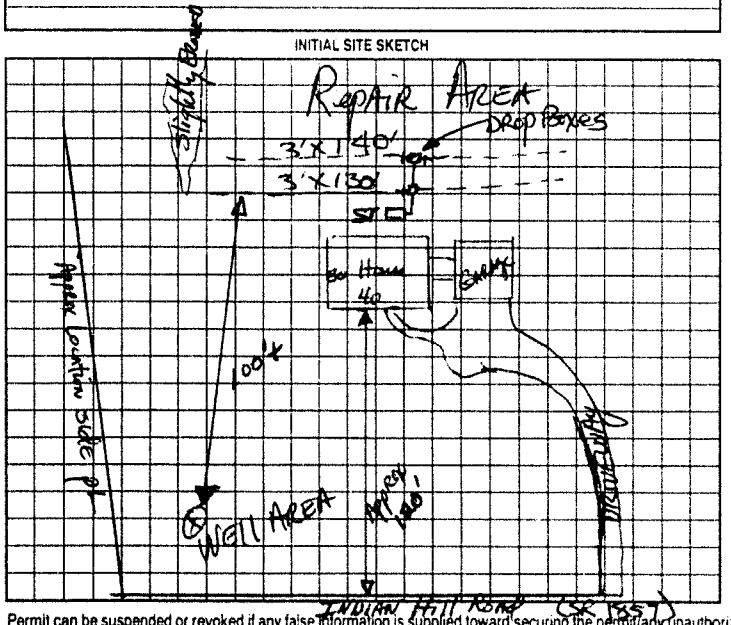


AS BUILT SKETCH

SYSTEM INSTALLED ACCORDING TO INITIAL SITE SKETCH

Permit can be suspended or revoked if any false information is supplied toward securing the permit/any unauthorized changes are made to the site/any unauthorized changes are made in the installation of the system. Improvement Permit with plat valid without expiration. Improvement Permit with site plan valid for sixty months. Authorization to Construct is valid for a period equal to that of Improvement Permit – not to exceed sixty months.

Signed: date Installed by: KENNY MADISON

Improvement Permit by: RS date 6-3-2000 Operation Permit by: STEVE HENRICK date 1-16-02

Authorization to Construct by: RS date 6-3-2000 Existing System Inspection by: date

HEALTH DEPT COPY WHITE OWNER COPY (FINAL) YELLOW OWNER COPY (INITIAL) PINK