IREDELL COUNTY HEALTH DEPARTMENT

STATESVILLE 704-878-5305 MOORESVILLE 704-664-5281

IMPROVEMENT PERMIT / AUTHORIZATION TO CONSTRUCT / OPERATION PERMIT / EXISTING SYSTEM INSPECTION

PERMIT# 076947 PIN# 4843 05 2081 DATE 10-26-98

OWNER OR CONTRACTOR DOUGLAS L. ADDIS PHONE: Business 539-5000 Home 539-5060

ADDRESS P.O. BOX 128, UNION GROVE, NC 28689

LOCATION I-77 N, TL NC 901, ~ 0.2 MILE ON LEFT PAST WARREN RAGSDALE ROAD AT BOX # 333

SUBDIVISION _____ BLOCK / SECTION _____ LOT _____ LOT AREA 15.2 ACRES SITE CLASS PS DESIGN FLOW 360 L.T.A.R. 0.30 GAD/FT²

Septic Tank: 1000 Gallons; STB 1012 Date 6-20-99

Pump Tank: _____ Gallons; PT _____ Date _____

Pump Make: _____ Model _____ Serial No. _____

Nitrification Field: No Fields 1 Square Feet 990 Linear Feet 330

No Lines THREE Trench Width 36" Max Trench Bottom Depth 36" Gravel Depth 12"

☒ New System ☐ Repair System Type: I II III IV V VI

System Description: CONVENTIONAL GRAVITY

Repair System Description: CONV. GRAVITY

Maintenance Agreement Required: ☐ Yes ☒ No

☐ Slab ☐ Crawl Space ☐ Basement w/plumbing ☐ Basement wo/plumbing

☐ House/Mod. Home No. Bedrooms 3

☐ Mobile Home No. Bathrooms 3

☒ Business No. Employees 12

☐ Other W/12 EMPLOYEES @ 25GPD


Water Supply: ☒ Individual ☐ Public ☐ Community

Comments:/Conditions:


S

Comments:/Conditions: SEPTIC TANK WITH ADDITIONAL REINFORCEMENT INSTALLED WITH CONCRETE RISERS AND "POLYLOK" FILTER

INITIAL SITE SKETCH

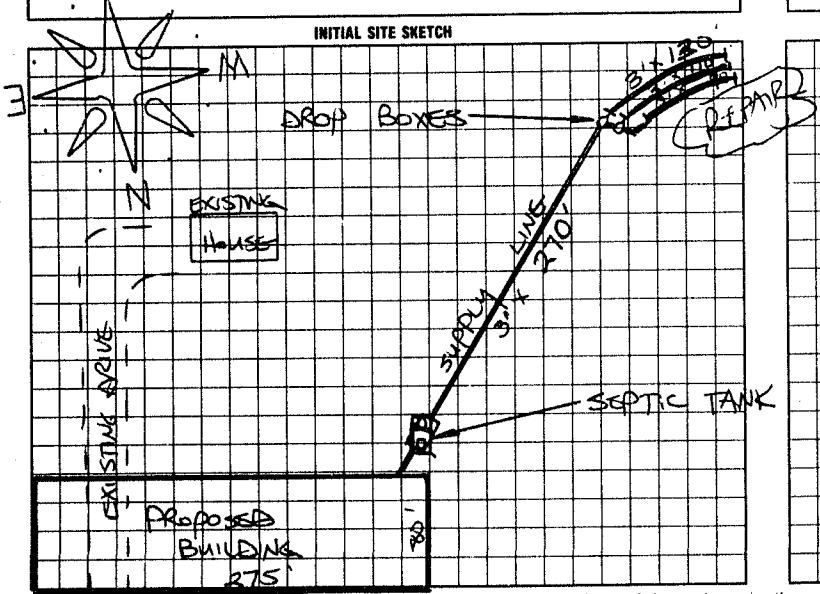

AS BUILT SKETCH

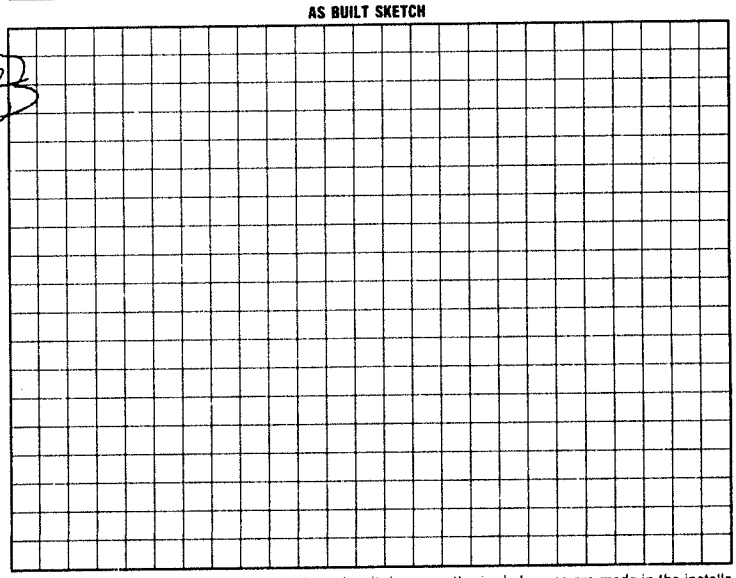

I understand that this permit can be suspended or revoked if any false information is supplied toward securing the permit/any unauthorized changes are made to the site/any unauthorized changes are made in the installation of the system. Improvement Permit with plat valid without expiration. Improvement Permit with site plan valid for sixty months. Authorization to Construct is valid for a period equal to that of Improvement Permit – not to exceed sixty months.

Signed: _____ date 10-26-98

Improvement Permit by: STEVE HEDRICK date 10-26-98

Authorization to Construct by: STEVE HEDRICK date 10-26-98

Installed by: Unknown

Operation Permit by: Mark Croft RS date 7-21-99

Existing System Inspection by: _____ date _____

HEALTH DEPT. COPY: WHITE INSPECTION COPY (FINAL): GREEN OWNER COPY (FINAL): YELLOW INSPECTION COPY (INITIAL): PINK OWNER COPY (INITIAL): GOLD