IREDELL COUNTY HEALTH DEPARTMENT

STATESVILLE 704-878-5305 CI MOORESVILLE 704-664-5281

IMPROVEMENT PERMIT / AUTHORIZATION TO CONSTRUCT / OPERATION PERMIT / EXISTING SYSTEM INSPECTION

PERMIT# 116088 PIN# 4843-40-6736 (Patsy Haynes - Applicant) DATE 10/6/03

OWNER OR CONTRACTOR Pauline Johnson PHONE: ~~Business~~ (704) 539-4467 C Home (704) 539-5459

ADDRESS 3408 Jennings Road Union Grove N.C. 28689

LOCATION I-77 N, Q Hwy 901 Q Jennings Road, 4th house on Q @ 3367 Jennings Road.

SUBDIVISION — BLOCK / SECTION — LOT — LOT AREA 9.97 Acres SITE CLASS. 5 DESIGN FLOW 360 L.T.A.R. - 35 gpd

Septic Tank: 1000 Gallons: STB — Date —

Pump Tank: — Gallons: PT — Date —

Pump Make: — Model — Serial No. —

Nitrification Field: No Fields 1 Square Feet 660 Linear Feet 220

No Lines 3 Trench Width 36" Max Trench Bottom Depth 30" Gravel Depth 12"

☒ New System ☐ Repair System Type: I (II) III, IV, V, VI

System Description: Gravity, Conventional

Repair System Description: Gravity; 25% Reduction

Maintenance Agreement Required: ☐ Yes ☒ No

☐ House/Mod. Home ☒ Mobile Home ☐ Business ☐ Other

No. Bedrooms 3 No. Bathrooms 2 No. Employees —


☐ Slab ☒ Crawl Space ☐ Basement w/plumbing ☐ Basement wo/plumbing

Water Supply: ☐ Individual ☒ Public ☐ Community


Comments:/Conditions: (1) Install New lines on Contour (2) Connect into Existing bed using drop box to new lines. (Ref: Joe Johnson 8/3/93)

Comments:/Conditions:

INITIAL SITE SKETCH

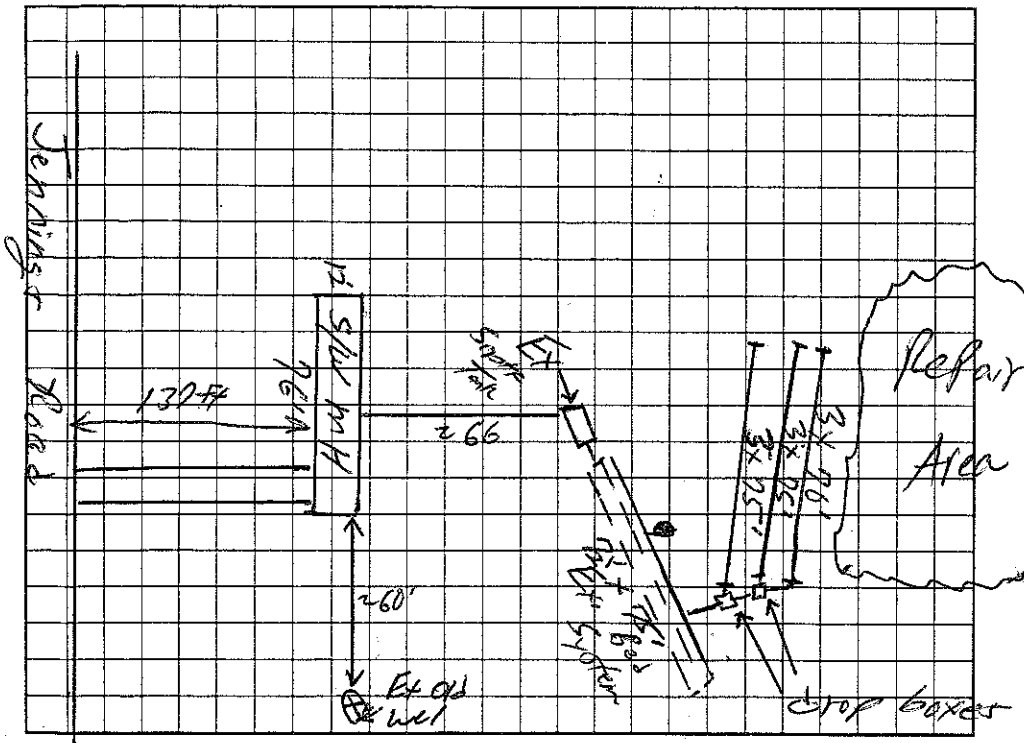

AS BUILT SKETCH

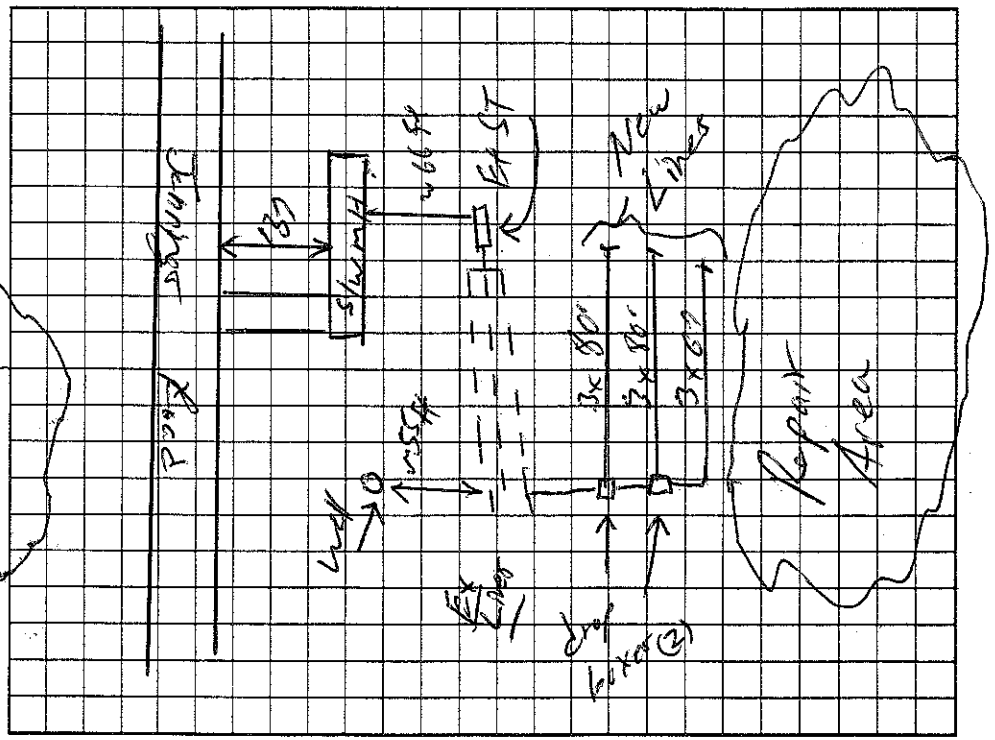

Permit can be suspended or revoked if any false information is supplied toward securing the permit/any unauthorized changes are made to the site/any unauthorized changes are made in the installation of the system. Improvement Permit with plat valid without expiration. Improvement Permit with site plan valid for sixty months. Authorization to Construct is valid for a period equal to that of Improvement Permit – not to exceed sixty months.

Signed: Patsy S. Haynes date 10-17-03 Installed by: Sammy Reavis

Improvement Permit by: William O. Johnson date 10/6/03 Operation Permit by: William O. Johnson date 11/12/03

Authorization to Construct by: William O. Johnson date 10/6/03 Existing System Inspection by: — date —

HEALTH DEPT. COPY: WHITE OWNER COPY (FINAL): YELLOW OWNER COPY (INITIAL): PINK