IREDELL COUNTY HEALTH DEPARTMENT

STATESVILLE 704-878-5305 CI MOORESVILLE 704-664-5281

IMPROVEMENT PERMIT / AUTHORIZATION TO CONSTRUCT / OPERATION PERMIT / EXISTING SYSTEM INSPECTION

(C)

PERMIT# 112533 PIN# 4843-49-8393 DATE 5-27-03

OWNER OR CONTRACTOR ALICE M. SMITH PHONE: Business % 704-278-2061 Home 704-873-0319

ADDRESS 1520 THIRD CREEK CHURCH ROAD CLEVELAND, NC 27013

LOCATION I-77 N, TL NR 901, TR WARREN BRIDGE ROAD, TR MITCH ROAD, 0.4 MILE ON RIGHT, 600 FEET BACK

SUBDIVISION _____ BLOCK / SECTION _____ LOT _____ LOT AREA 66.63 ACRES SITE CLASS. PS' DESIGN FLOW 240 L.T.A.R. 0.30 GPD/FT²

Septic Tank: 1000 Gallons; STB 620 Date 11-5-02
Pump Tank: _____ Gallons; PT _____ Date _____
Pump Make: _____ Model _____ Serial No. _____
Nitrification Field: No Fields 1 Square Feet 810 Linear Feet 270
No Lines THREE Trench Width 36" Max Trench Bottom Depth 36" Gravel Depth 12'

☑ New System ☐ Repair System Type: I, (II), III, IV, V, VI
System Description: CONVENTIONAL, GRAVITY
Repair System Description: CONVENTIONAL, GRAVITY
Maintenance Agreement Required: ☐ Yes ☑ No

☐ House/Mod. Home No. Bedrooms 2
☑ Mobile Home No. Bathrooms 1½
☐ Business No. Employees _____
☐ Other _____
☐ Slab ☑ Crawl Space ☐ Basement w/plumbing ☐ Basement wo/plumbing


Water Supply:
☑ Individual
☐ Public
☐ Community
WELL

Comments:/Conditions: INSTALL SUBSURFACE INTERCEPT DRAINAGE DITCH AT LOCATION SHOWN BEGINNING 48" DEEP


Comments:/Conditions: - Zabel filter Installed

SCALE: 1" = 40'

INITIAL SITE SKETCH

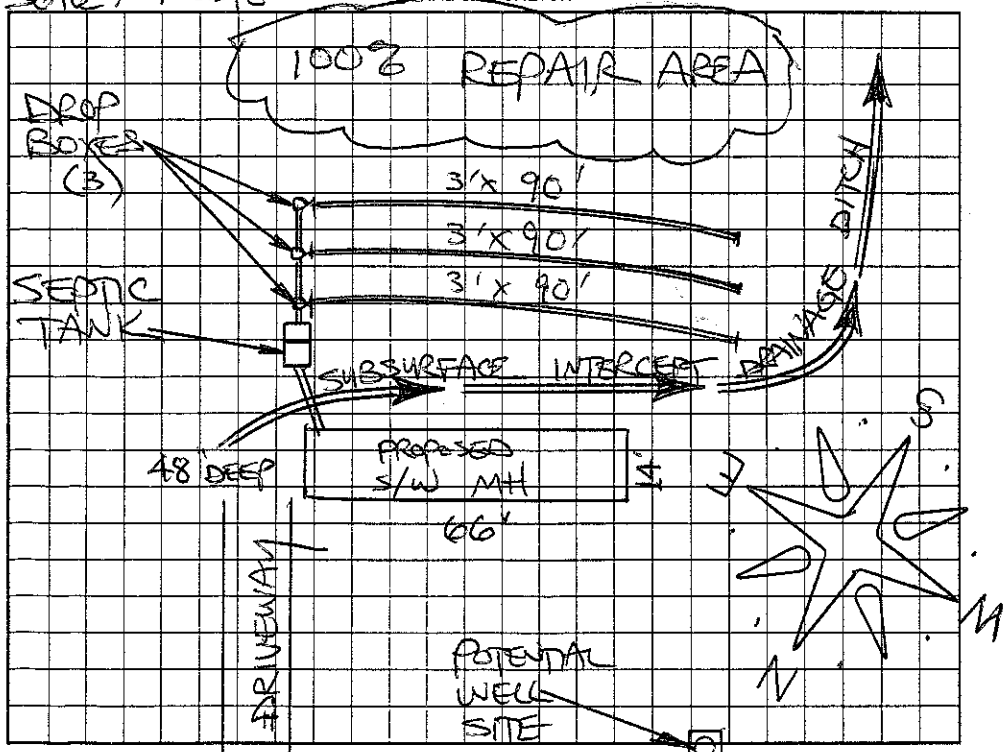

AS BUILT SKETCH

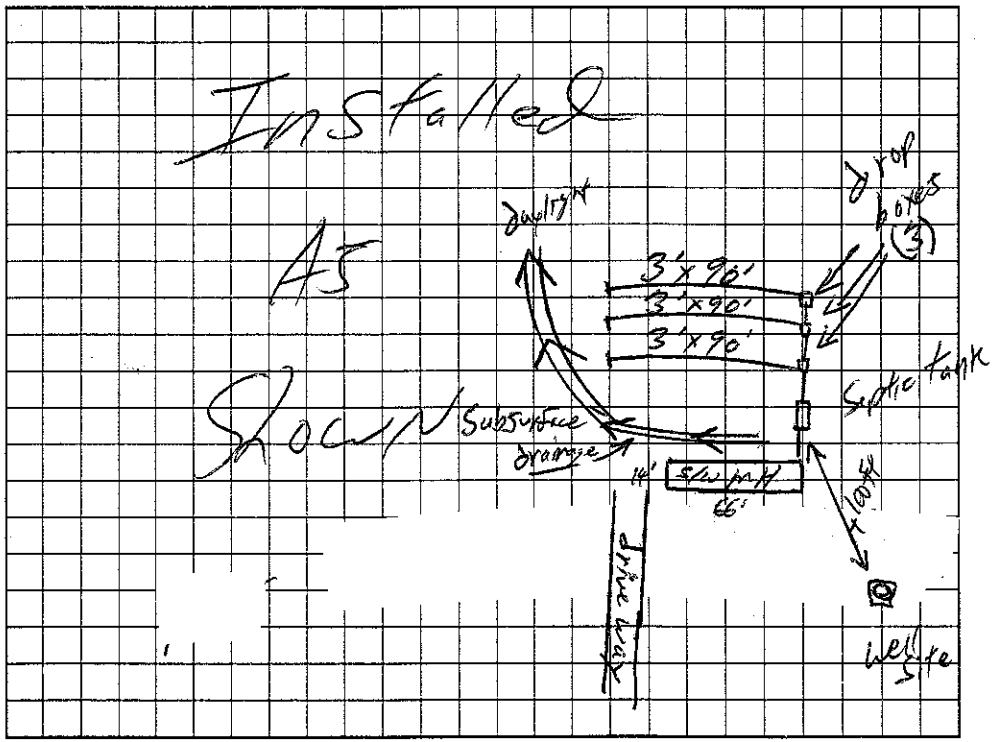

Permit can be suspended or revoked if any false information is supplied toward securing the permit/any unauthorized changes are made to the site/any unauthorized changes are made in the installation of the system. Improvement Permit with plat valid without expiration. Improvement Permit with site plan valid for sixty months. Authorization to Construct is valid for a period equal to that of Improvement Permit – not to exceed sixty months.

Signed: X Alice M. Smith date 5/27/03 Installed by: Sammy Reavis

Improvement Permit by: STEVE HEDRICK date 5-27-03 Operation Permit by: William O. Johnson date 9/19/03

Authorization to Construct by: STEVE HEDRICK date 5-27-03 Existing System Inspection by: _____ date _____

HEALTH DEPT. COPY: WHITE OWNER COPY (FINAL): YELLOW OWNER COPY (INITIAL): PINK