IREDELL COUNTY HEALTH DEPARTMENT

THIS PERMIT VOIDS PREVIOUS ISSUED 12-12-01

STATESVILLE 704-878-5305 (CI) MOORESVILLE 704-664-5281

IMPROVEMENT PERMIT / AUTHORIZATION TO CONSTRUCT / OPERATION PERMIT / EXISTING SYSTEM INSPECTION

PERMIT# 102576 PIN# 4843-55-5738 DATE 7-8-02

OWNER OR CONTRACTOR HELENE CAMPBELL PHONE Business (704) 838-8210 Home (704) 539-5304

ADDRESS 272 HOWARD BRIDGE ROAD, UNION GROVE, NC 28689

LOCATION US 21 N, TL JENNINGS RD, TL NC 901 0.1 MILE ON RIGHT

SUBDIVISION _____ BLOCK / SECTION _____ LOT _____ LOT AREA 27.57 ACRES SITE CLASS PS DESIGN FLOW 360 L.T.A.R. 0.30 GPD/FT²

Septic Tank: 1000 Gallons: STB 1072 Date 1-21-02

Pump Tank: _____ Gallons: PT _____ Date _____

Pump Make: _____ Model _____ Serial No _____

Nitrification Field: No Fields 1 Square Feet 1200 Linear Feet 400

No Lines FOUR Trench Width 36" Max Trench Bottom Depth 32" Gravel Depth 12"

New System Repair System Type: I II III IV V

System Description: CONVENTIONAL, GRAVITY

Repair System Description: CONVENTIONAL, PUMP

Maintenance Agreement Required: Yes No

Slab Crawl Space Basement w/plumbing Basement wo/plumbing

House/Mod. Home No Bedrooms 3

Mobile Home No. Bathrooms 2

Business No Employees _____


Other _____

Water Supply: Individual Public Community

Comments/Conditions: INSTALL LINES ON CONTOUR AS FLAGGED NO DEEPER THAN 32".

Comments/Conditions: SEPTIC TANK WITH MARKER INSTALLED USING "POLYLOK" FILTER

INITIAL SITE SKETCH

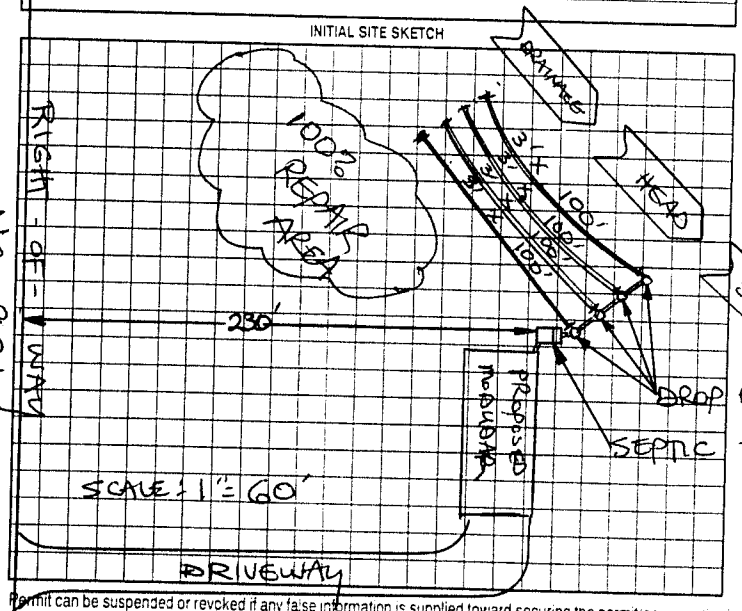

AS BUILT SKETCH

SYSTEM INSTALLED ACCORDING TO INITAL SITE SKETCH

Permit can be suspended or revoked if any false information is supplied toward securing the permit, any unauthorized changes are made to the site, any unauthorized changes are made in the installation of the system. Improvement Permit with plat valid without expiration. Improvement Permit with site plan valid for sixty months. Authorization to Construct is valid for a period equal to that of Improvement Permit – not to exceed sixty months.

Signed: Helene Campbell date 7-11-02 Installed by CRAIG THOMPSON

Improvement Permit by: STEVE HEDRICK date 7-8-02 Operation Permit by STEVE HEDRICK date 8-19-02

Authorization to Construct by: STEVE HEDRICK date 7-8-02 Existing System Inspection by: _____ date _____

HEALTH DEPT COPY WHITE OWNER COPY (FINAL) YELLOW OWNER COPY (INITIAL) PINK