IREDELL COUNTY HEALTH DEPARTMENT

STATESVILLE 704-878-5305 MOORESVILLE 704-664-5281

IMPROVEMENT PERMIT / AUTHORIZATION TO CONSTRUCT / OPERATION PERMIT / EXISTING SYSTEM INSPECTION

PERMIT# 117672 PIN# 4843-65-~~2623.001~~ 3127 DATE 1-15-04

OWNER OR CONTRACTOR Luther Wayne Frye PHONE: Business 336-462-4586 Home

ADDRESS 410 Hwy 58 Advance, NC 27006

LOCATION I-77N EXIT 65 (L) NC 901 (R) Angus Hill Prop on left @ end of road.

SUBDIVISION BLOCK / SECTION LOT LOT AREA 2.00 AC SITE CLASS. PS DESIGN FLOW 360 L.T.A.R. .25 gpd/ft²

Septic Tank: 1000 Gallons; STB 760 Date 2-28-04
Pump Tank: Gallons; PT Date
Pump Make: Model Serial No.
Nitrification Field: No Fields 1 Square Feet 1440 Linear Feet 480
No Lines 4 Trench Width 36" Max Trench Bottom Depth 24" Gravel Depth 12"

☑ New System ☐ Repair System Type: I, (II) III, IV, V, VI
System Description: Con Gravity
Repair System Description: Grav 25% reduction
Maintenance Agreement Required: ☐ Yes ☑ No


☑ House/Mod. Home No. Bedrooms 3
☐ Mobile Home No. Bathrooms 3
☐ Business No. Employees
☐ Other
☐ Slab ☐ Crawl Space ☐ Basement w/plumbing ☑ Basement wo/plumbing

Water Supply: ☑ Individual ☐ Public ☐ Community Well


Comments:/Conditions: (1) Maintain all setbacks (2) Install lines on contour at 24" depth (3) Will need to smooth terrace before installation (4) Well must be a minimum 100' from any part of septic system. (*) MUST MEET INSTALLER PRIOR TO START OF SYSTEM (*)

Comments:/Conditions: (1) Red Polylok filter (2) #5 stone

INITIAL SITE SKETCH SCALE 1" = 60'

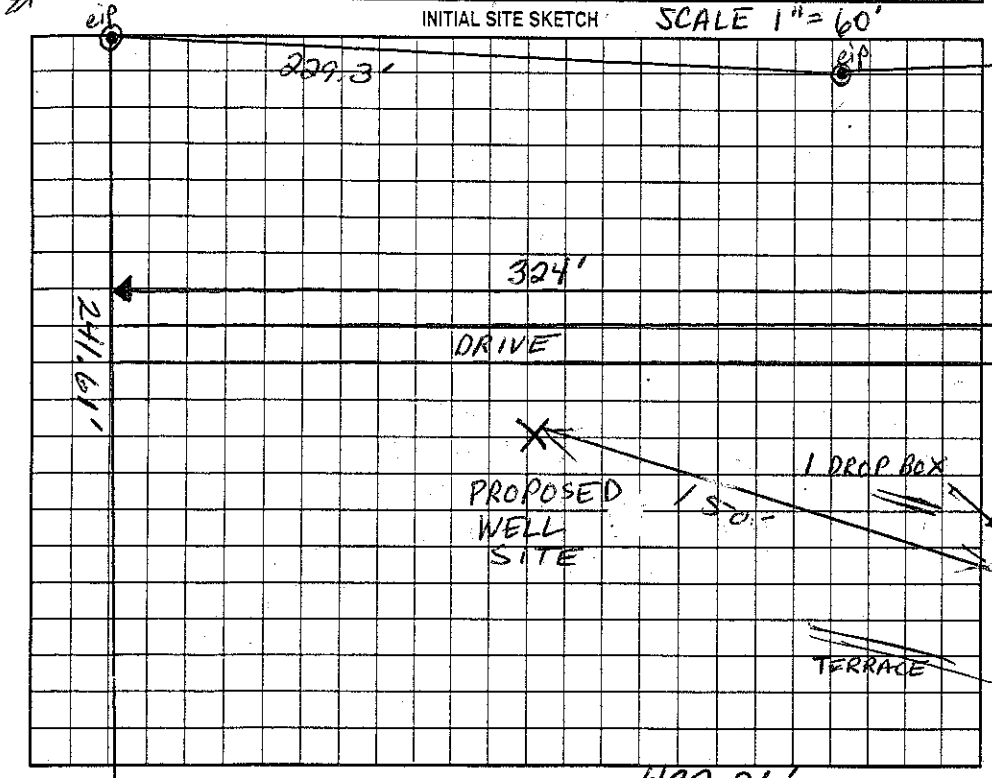

AS BUILT SKETCH

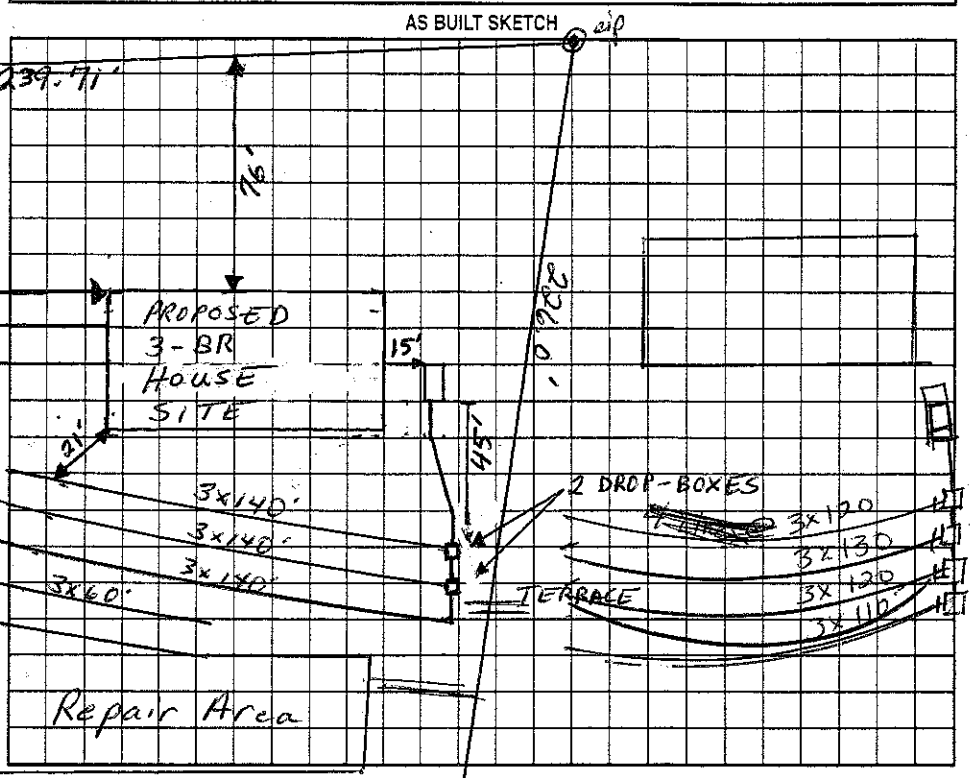

Permit can be suspended or revoked if any false information is supplied toward securing the permit/any unauthorized changes are made to the site/any unauthorized changes are made in the installation of the system. Improvement Permit with plat valid without expiration. Improvement Permit with site plan valid for sixty months. Authorization to Construct is valid for a period equal to that of Improvement Permit – not to exceed sixty months.

Signed: Luther W. Frye date 1/20/04 Installed by: Donald Lakey

Improvement Permit by: Christopher M. Sherrill, R.S. date 1/15/04 Operation Permit by: Christopher M. Sherrill, R.S. date 7-23-04

Authorization to Construct by: Christopher M. Sherrill, R.S. date 1/20/04 Existing System Inspection by: date

HEALTH DEPT. COPY: WHITE OWNER COPY (FINAL): YELLOW OWNER COPY (INITIAL): PINK