46700 ~~46796~~

IREDELL COUNTY HEALTH DEPARTMENT

STATESVILLE 704-878-5305 MOORESVILLE 704-664-5281

IMPROVEMENT PERMIT / CERTIFICATE OF COMPLETION / OPERATION PERMIT / EXISTING SYSTEM INSPECTION

PROPERTY DESCRIPTION NO. 1596 DATE 8/18/93 TAX MAP NO. 16M-A-68

OWNER OR CONTRACTOR UNION GROVE METHODIST CHURCH PHONE: Business 539-4394 Home 872-2473

ADDRESS

LOCATION I-77N, TL NC 901W, TL SLOANS MILL RD, CHURCH ON (R) ~ 0.25 MILE

SUBDIVISION BLOCK / SECTION LOT LOT AREA SITE CLASS. PS L.T.A.R. 0.30 GPD/FT²

Water Supply: ☐ Individual ☐ Community ☑ Public

Septic Tank: 1250 Gallons: STB 564 Date 6/30/92

Pump Tank: Gallons: PT Date

Nitrification Field: No Fields 1 Square Feet 1860 Linear Feet 620

No Lines 4 Trench Width 36" Trench Depth Gravel Depth 12"

☐ New System ☐ Repair System Type: I, II, III, IV, V, VI

System Description: CONV. GRAVITY

Repair System Description: CONV. GRAVITY

Maintenance Agreement Required: ☐ Yes ☑ No

☐ House/Mod. Home ☐ Mobile Home ☐ Business ☑ Other CHURCH W/ 185 SEATS @ 6 GPD

No. Bedrooms N/A No. Bathrooms 2 No. Employees

☑ Slab ☐ Crawl Space ☐ Basement w/plumbing ☐ Basement wo/plumbing

Garbage Disposal: ☐ Yes ☑ No

Auto. Dishwasher: ☐ Yes ☑ No

Auto. Washing Machine: ☐ Yes ☑ No


Other 1949 (c)(1)

Comments FLOW REDUCTION BASED UPON DOCUMENTATION ~~PROVIDED~~ PROVIDED UNDER .1949 (c)(1)

REPAIR AREA 3'X160'

INITIAL SITE SKETCH

AS BUILT SKETCH

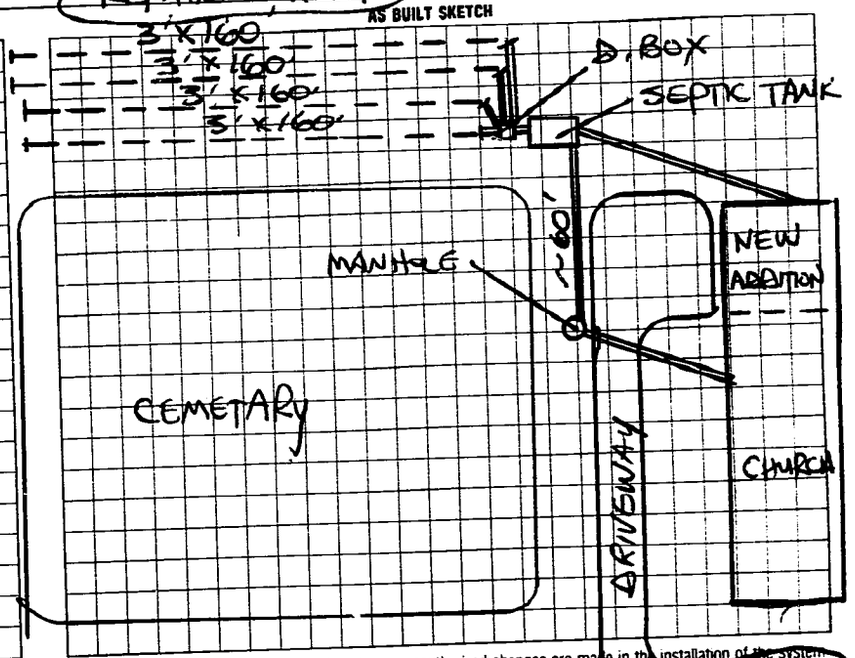

I understand that this permit can be suspended or revoked if any false information is supplied toward securing the permit/any unauthorized changes are made to the site/any unauthorized changes are made in the installation of the system. Improvement Permit is valid for 60 months from date of issuance.

Signed:

Improvement Permit by: STEVE HEARICK date 5/17/93

Existing System Inspection by: date

Installed by: A-1 BACKHOE

Certificate of Completion by: STEVE HEARICK date 8/18/93

Operation Permit by: date

HEALTH DEPT. COPY: WHITE INSPECTION COPY (FINAL): GREEN OWNER COPY (FINAL): YELLOW INSPECTION COPY (INITIAL): PINK OWNER COPY (INITIAL): GOLD

SLOANS MILL ROAD