IREDELL COUNTY HEALTH DEPARTMENT

STATESVILLE 704-878-5305 (C1) MOORESVILLE 704-664-5281

IMPROVEMENT PERMIT / AUTHORIZATION TO CONSTRUCT / OPERATION PERMIT / EXISTING SYSTEM INSPECTION

PERMIT# 108124 PIN# 4843-81-0300 DATE 8-14-02

OWNER OR CONTRACTOR ZEB SPEESE PHONE: Business _____ Home 704-539-4715

ADDRESS 152 INDIAN HILL ROAD, UNION GROVE, NC 28689

LOCATION I-77 N, TL NC 901, TL SIOUNS MILL RD, TR INDIAN HILL ROAD, 3RD DWELLING ON RIGHT

SUBDIVISION _____ BLOCK / SECTION _____ LOT _____ LOT AREA 5.12 ACRES SITE CLASS PS DESIGN FLOW 240 L.T.A.R. 0.30 GPD/FT

Septic Tank: 1000 Gallons; STB 1000 Date 7-8-02
Pump Tank: _____ Gallons; PT _____ Date _____
Pump Make: _____ Model _____ Serial No _____
Nitrification Field: No Fields 1 Square Feet 810 Linear Feet 270
No Lines THREE Trench Width 36" Max Trench Bottom Depth 36" Gravel Depth 12"

☑ New System ☐ Repair System Type: I (II) III IV V VI
System Description: CONVENTIONAL, GRAVITY
Repair System Description: CONVENTIONAL, GRAVITY
Maintenance Agreement Required: ☐ Yes ☑ No
☐ Slab ☑ Crawl Space ☐ Basement w/plumbing ☐ Basement wo/plumbing

☐ House/Mod. Home No. Bedrooms 1
☑ Mobile Home No. Bathrooms 1
☐ Business No. Employees _____
☐ Other _____


Water Supply: ☐ Individual ☑ Public ☐ Community

~ 0.2 MILE

Comments/Conditions:

Comments/Conditions: SEPTIC TANK W/ RISERS & MARKER INSTALLED USING "ZABEL" FILTER

INITIAL SITE SKETCH

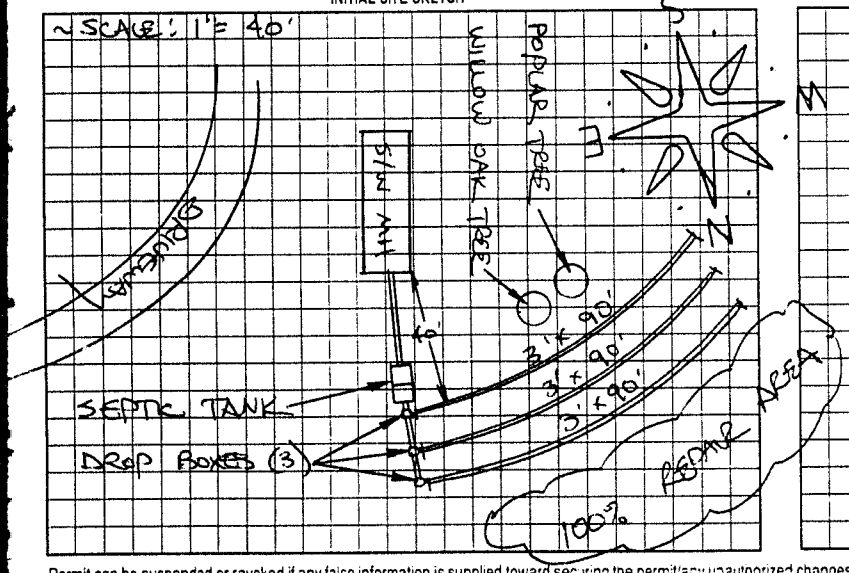

AS BUILT SKETCH

SYSTEM INSTALLED ACCORDING TO INITAL SITE SKETCH

Permit can be suspended or revoked if any false information is supplied toward securing the permit; any unauthorized changes are made to the site; any unauthorized changes are made in the installation of the system. Improvement Permit with plat valid without expiration. Improvement Permit with site plan valid for sixty months. Authorization to Construct is valid for a period equal to that of Improvement Permit - not to exceed sixty months

Signed: Zeb Speese date 8-14-02 Installed by: DON SURGEON

Improvement Permit by: STEVE HENDRICK date 8-14-02 Operation Permit by: STEVE HENDRICK date 10-7-02

Authorization to Construct by: STEVE HENDRICK date 8-14-02 Existing System Inspection by: _____ date _____

HEALTH DEPT. COPY: WHITE OWNER COPY (FINAL): YELLOW OWNER COPY (INITIAL): PINK