IREDELL COUNTY HEALTH DEPARTMENT

STATESVILLE 704-878-5305 MOORESVILLE 704-664-5281

IMPROVEMENT PERMIT / AUTHORIZATION TO CONSTRUCT / OPERATION PERMIT / EXISTING SYSTEM INSPECTION

PERMIT# 118463 PIN# 4843-81-2518 DATE 2/18/04

OWNER OR CONTRACTOR SALLEY BAKER PHONE: Business 704-902-4629 Home

ADDRESS 126 INDIAN HILL RD. UNION GROVE, NC 28689

LOCATION I-77N EXT 65 (L) 901 (L) SLOAN MILL RD (R) INDIAN HILL RD 2ND HOUSE ON (R)

SUBDIVISION BLOCK / SECTION LOT LOT AREA 1.21 SITE CLASS. PS DESIGN FLOW 360 L.T.A.R. EXISTING

Septic Tank: EXISTING Gallons: STB Date

Pump Tank: Gallons: PT Date

Pump Make: Model Serial No.

Nitrification Field: No Fields 1 Square Feet Linear Feet EXIST

No Lines EXIST. Trench Width Max Trench Bottom Depth Gravel Depth

☐ New System ☐ Repair System Type: I (II) III, IV, V, VI

System Description: CONV. GRAVITY

Repair System Description:

Maintenance Agreement Required: ☐ Yes ☑ No

☑ House/Mod. Home No. Bedrooms 3

☐ Mobile Home No. Bathrooms 2

☐ Business No. Employees

☐ Other


☐ Slab ☑ Crawl Space ☐ Basement w/plumbing ☐ Basement wo/plumbing

Water Supply: ☐ Individual ☑ Public ☐ Community IREDELL WATER


Comments:/Conditions:

Comments:/Conditions: (1) SYSTEM FUNCTIONING PROPERLY AT TIME OF INSPECTION (2) PERMISSION GIVEN TO CONSTRUCT STRUCTURE TO EXISTING SYSTEM (3) VISUAL INSPECTION ONLY. DOES NOT GUARANTEE SYSTEM WILL WORK IN FUTURE.

INITIAL SITE SKETCH

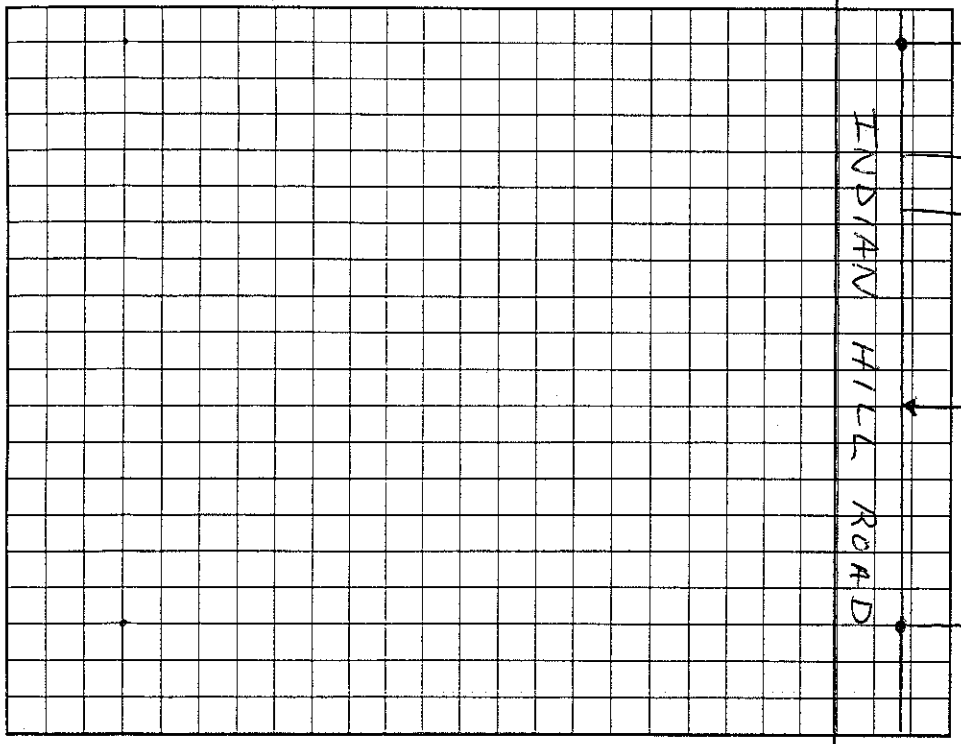

AS BUILT SKETCH (SCALE 1"=50')

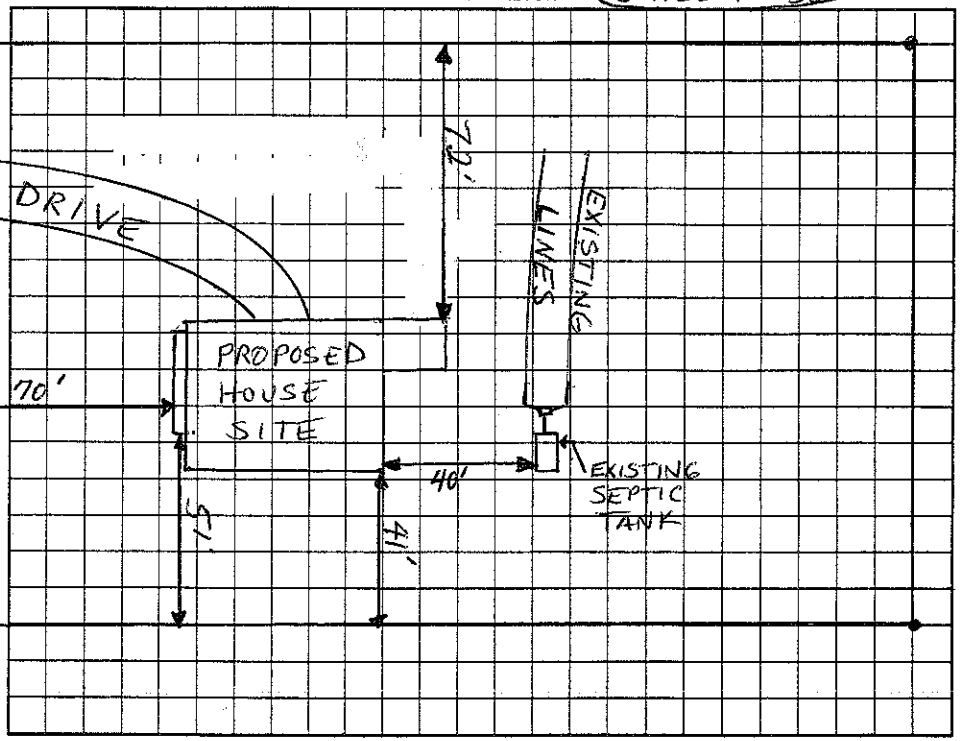

Permit can be suspended or revoked if any false information is supplied toward securing the permit/any unauthorized changes are made to the site/any unauthorized changes are made in the installation of the system. Improvement Permit with plat valid without expiration. Improvement Permit with site plan valid for sixty months. Authorization to Construct is valid for a period equal to that of Improvement Permit – not to exceed sixty months.

Signed: Matt Caudle date 2-18-04 Installed by:

Improvement Permit by: date Operation Permit by: date

Authorization to Construct by: date Existing System Inspection by: Christopher M. Shemwell, RS date 2-18-04

HEALTH DEPT. COPY: WHITE OWNER COPY (FINAL): YELLOW OWNER COPY (INITIAL): PINK