IREDELL COUNTY HEALTH DEPARTMENT

STATESVILLE 704-878-5305 MOORESVILLE 704-664-5281

IMPROVEMENT PERMIT / AUTHORIZATION TO CONSTRUCT / OPERATION PERMIT / EXISTING SYSTEM INSPECTION

PERMIT# REPAIR PIN# 4843-81-8724 07 DATE 4-13-05

OWNER OR CONTRACTOR ANTHONY E. GILBERT PHONE: Business (704) 546-7002 Home

ADDRESS 1276 SLOANS MILL RD. UNION GROVE NC 28689

LOCATION I-77N TO EXIT 65 TL HWY 901 TL SLOANS MILL RD. LOT ON LEFT

SUBDIVISION BLOCK / SECTION LOT LOT AREA 2.00 SITE CLASS PS DESIGN FLOW 360 L.T.A.R. EXISTING

Septic Tank: ~~NEW~~ EX Gallons; STB Date

Pump Tank: Gallons; PT Date

Pump Make: Model Serial No.

Nitrification Field: No Fields 1 Square Feet Linear Feet 140

No Lines 2 Trench Width 36" Max Trench Bottom Depth 36"-48" Gravel Depth 24"

☐ New System ☑ Repair System Type: I, (II), III, IV, V, VI

System Description: 1

Repair System Description: CONVENTIONAL GRAVITY

Maintenance Agreement Required: ☐ Yes ☑ No

☑ House/Mod. Home No. Bedrooms 3

☐ Mobile Home No. Bathrooms

☐ Business No. Employees

☐ Other


☐ Slab ☑ Crawl Space ☐ Basement w/plumbing ☐ Basement wo/plumbing

Water Supply: ☑ Individual ☑ Public ☐ Community


Comments/Conditions: (1) INSTALL ON CONTOUR (2) SMOOTH OUT ROUGH TOPOGRAPHY (3) DISCONTINUE (4) THIS PERMIT SERVES AS A 30-DAY NOV EXPIRING 5-13-05

Comments/Conditions: (1) CAN USE EXISTING TANK - IN GOOD REPAIR (2) PUMP OUT TANK INSTALL FILTER TEE (3) BULL RUN VALVE REQD TO SWITCH BETWEEN SYSTEMS

INITIAL SITE SKETCH

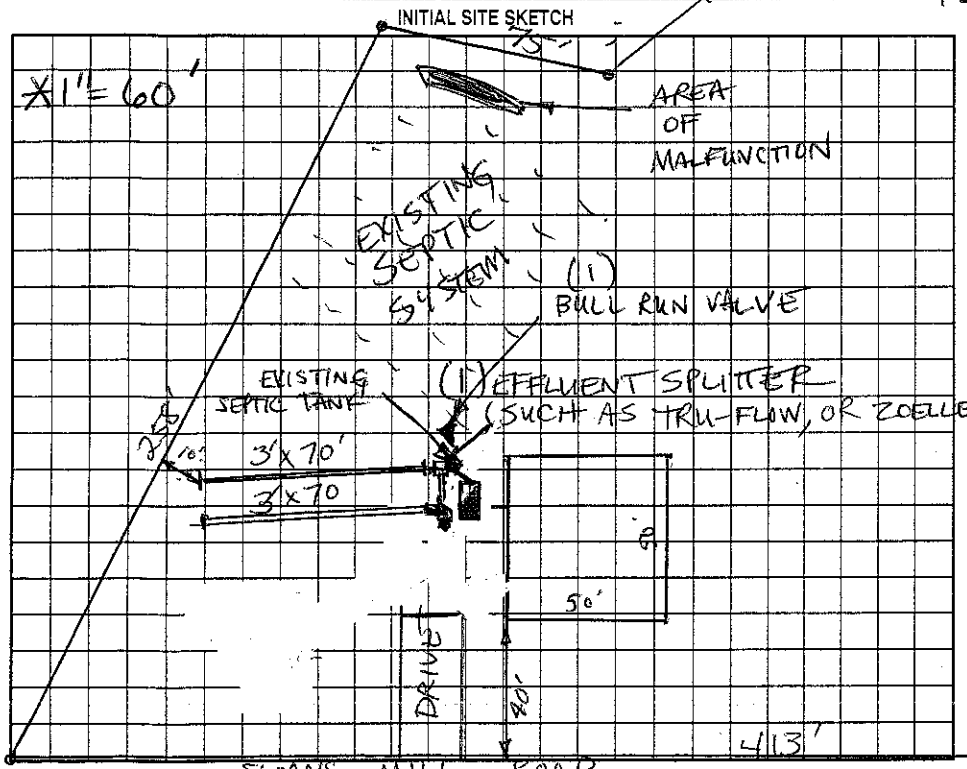

AS BUILT SKETCH

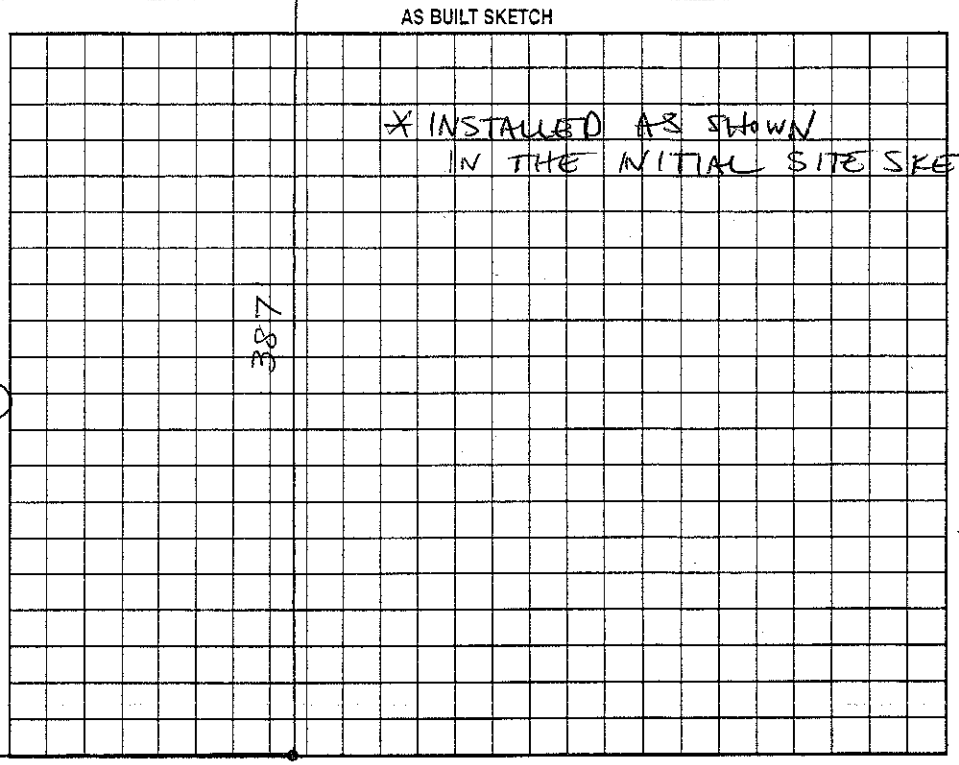

Permit can be suspended or revoked if any false information is supplied toward securing the permit/any unauthorized changes are made to the site/any unauthorized changes are made in the installation of the system. Improvement Permit with plat valid without expiration. Improvement Permit with site plan valid for sixty months. Authorization to Construct is valid for a period equal to that of Improvement Permit – not to exceed sixty months.

Signed: Anthony E. Gilbert date

Improvement Permit by: Christy M. Sherrill RS, LSS date 4-13-05

Authorization to Construct by: Christy M. Sherrill RS, LSS date 4-13-05

Installed by: KENNY MADISON

Operation Permit by: Christy M. Sherrill RS, CSS date 5-31-05

Existing System Inspection by: date

HEALTH DEPT. COPY: WHITE OWNER COPY (FINAL): YELLOW OWNER COPY (INITIAL): PINK