IREDELL COUNTY HEALTH DEPARTMENT

STATESVILLE 704-878-5305 MOORESVILLE 704-664-5281

IMPROVEMENT PERMIT / AUTHORIZATION TO CONSTRUCT / OPERATION PERMIT / EXISTING SYSTEM INSPECTION

PERMIT# 086182 PIN# 4843 82 8773 DATE 12-8-99

OWNER OR CONTRACTOR HARPER VAN HOY PHONE: Business Home 539-4417

ADDRESS 235 WARREN BRIDGE ROAD, UNION GROVE, NC 28689

LOCATION I-77 N, TL NC 901, TR UNION GROVE ROAD, 1ST LOT ON RIGHT

SUBDIVISION BLOCK / SECTION LOT LOT AREA 1.269 ACRES SITE CLASS PS DESIGN FLOW 100 L.T.A.R. 0.30 GPD/FT²

Septic Tank: 1000 Gallons; STB 1012 Date 11-2-99

Pump Tank: Gallons; PT Date

Pump Make: Model Serial No.

Nitrification Field: No Fields 1 Square Feet 360 Linear Feet 120

No Lines TWO Trench Width 36" Max Trench Bottom Depth 36" Gravel Depth 12"

☑ New System ☐ Repair System Type: I (II) III. IV. V. VI

System Description: CONVENTIONAL GRAVITY

Repair System Description: CONVENTIONAL GRAVITY

Maintenance Agreement Required: ☐ Yes ☑ No

☐ House/Mod. Home No. Bedrooms

☐ Mobile Home No. Bathrooms

☑ Business No. Employees 2

☐ Other POST OFFICE


☐ Slab ☐ Crawl Space ☐ Basement w/plumbing ☐ Basement wo/plumbing

Water Supply: ☐ Individual ☑ Public ☐ Community


Comments/Conditions: INSTALL DRAINLINES ON CONTOUR AS FLAGGED ON SITE

Comments/Conditions: THIS PERMIT ISSUED 4-3-2000

INITIAL SITE SKETCH SCALE: 1"=40'

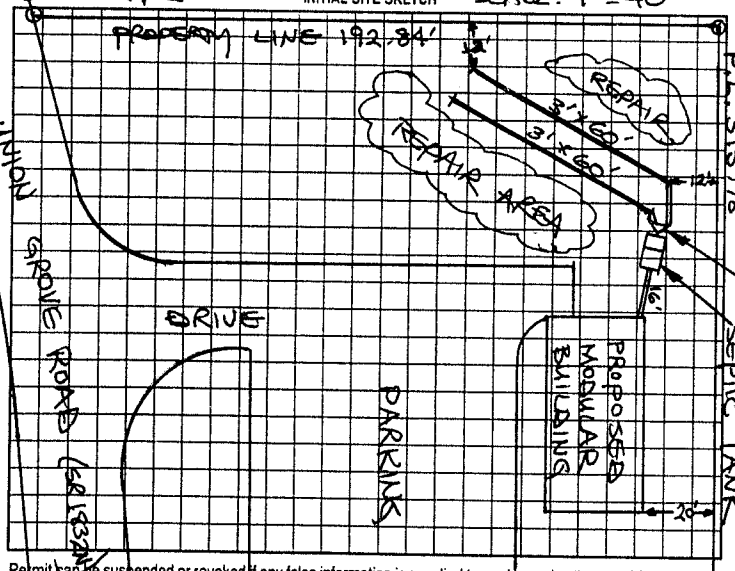

AS BUILT SKETCH

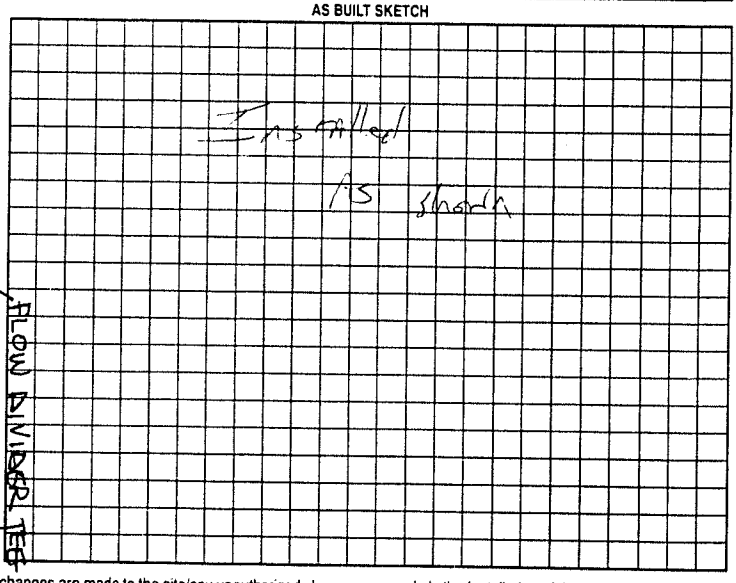

Permit can be suspended or revoked if any false information is supplied toward securing the permit/any unauthorized changes are made to the site/any unauthorized changes are made in the installation of the system. Improvement Permit with plat valid without expiration. Improvement Permit with site plan valid for sixty months. Authorization to Construct is valid for a period equal to that of Improvement Permit – not to exceed sixty months.

Signed: date 4-3-00

Improvement Permit by: STEVE HEARICK date 12-8-99

Authorization to Construct by: STEVE HEARICK date 12-8-99

Installed by: date

Operation Permit by: date April 7 2000

Existing System Inspection by: date

HEALTH DEPT. COPY: WHITE OWNER COPY (FINAL): YELLOW OWNER COPY (INITIAL): PINK