IREDELL COUNTY HEALTH DEPARTMENT

STATESVILLE 704-878-5305 MOORESVILLE 704-664-5281

IMPROVEMENT PERMIT / AUTHORIZATION TO CONSTRUCT / OPERATION PERMIT / EXISTING SYSTEM INSPECTION

PERMIT # 153123 PIN # 4843859011 DATE 10/28/08

OWNER or APPLICANT Jerry Myers PHONE: Business 704 902 1292 Home:

OWNER or APPLICANT ADDRESS 120 Howard Bridge Rd.

LOCATION / DIRECTIONS 77N, (L) 901, (R) Howards Bridge Rd, on (R)

SUBDIVISION n/a BLOCK / SECTION LOT # LOT AREA 31.38 DESIGN FLOW 240 L.T.A.R. Ex.

Septic Tank Ex Gallons: STB 1000 Date Ex

Pump Tank Ex n/a Gallons: P T Date

Pump Make Ex n/a Model n/a Serial #

Nitrification Field No Fields Ex No Lines Ex. Linear Feet Ex.

Trench Width Ex Max. Trench Bottom Depth Ex. Gravel Depth Ex.

☐ New System ☐ Repair ☐ Expansion System Type I (II) III IV V VI

System Description: Existing

Repair System Description:

Maintenance Agreement Required ☐ YES ■ NO

■ GRAVITY ☐ PRESSURE

■ Residence No. Bedrooms 2

☐ Business No. Persons

☐ Other No. Employees

☐ Slab ■ Crawl Space

☐ Basement w/plumbing ☐ Basement w/o plumbing


Water Supply: ☐ Private ■ Public ☐ Community

Comments / Conditions

Comments / Conditions

INITIAL SITE SKETCH

AS BUILT SKETCH

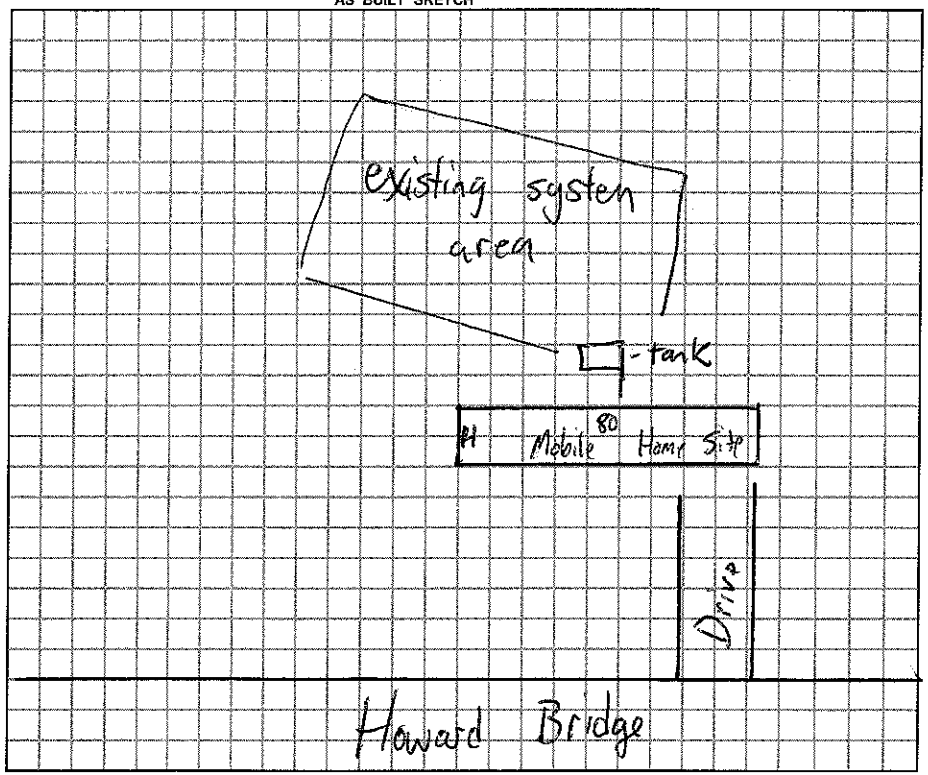

Permit can be suspended or revoked if any false information is supplied toward securing the permit / any unauthorized changes are made to the site / any unauthorized changes are made in the installation of the system.

☐ *IMPROVEMENT PERMIT w / plat valid without expiration.* ☐ *IMPROVEMENT PERMIT w / site plan valid for 60 mos.* ☐ *AUTHORIZATION TO CONSTRUCT valid for period equal to IMPROVEMENT PERMIT-not to exceed 60 mo.*

Owner / Applicant Signature: Jerry W Myers Date 10-29-08 Installed by:

Improvement Permit by: Date

Authorzation to Construct by: Date

Operation Permit by: Date:

Existing System Inspected by: Date: 10/28/08

YOU SHOULD CONTACT A LOCATOR SERVICE PRIOR TO ANY EXCAVATION.

WHITE COPY Environmental Health YELLOW COPY (Final) Owner / Applicant PINK COPY (Initial) Owner / Applicant