IREDELL COUNTY HEALTH DEPARTMENT

STATESVILLE 704-878-5305 MOORESVILLE 704-664-5281

IMPROVEMENT PERMIT / AUTHORIZATION TO CONSTRUCT / OPERATION PERMIT / EXISTING SYSTEM INSPECTION

PERMIT# REPAIR PIN# DATE 2-8-00

OWNER OR CONTRACTOR KYLE & MARJORIE HOLLOWAY PHONE: Business Home

ADDRESS 117 CHESTNUT OAK RD. UNION GROVE ROAD, NC 28689

LOCATION I-77 NORTH, TL NC 901, TL SLOANS MILL ROAD, TL CHESTNUT OAK RD. 1ST ON LEFT

SUBDIVISION BLOCK / SECTION LOT LOT AREA LIMITED SITE CLASS IS DESIGN FLOW 360 L.T.A.R. EXISTING

Septic Tank: EXISTING Gallons; STB Date

Pump Tank: Gallons; PT Date

Pump Make: Model Serial No.

Nitrification Field: No Fields 1 Square Feet 270 Linear Feet 90

No Lines TWO Trench Width 36" Max Trench Bottom Depth 36" Gravel Depth 24"

☐ New System ☑ Repair System Type: I, II, III, IV, V, VI

System Description: CONVENTIONAL GRAVITY

Repair System Description: CONV. GRAVITY

Maintenance Agreement Required: ☐ Yes ☐ No

☐ Slab ☐ Crawl Space ☐ Basement w/plumbing ☐ Basement wo/plumbing

☐ House/Mod. Home No. Bedrooms 3

☑ Mobile Home No. Bathrooms 2

☐ Business No. Employees


☐ Other

Water Supply: ☐ Individual ☑ Public ☐ Community


Comments:/Conditions: ① INSTALL TWO NEW LINES AS SHOWN 3'X 30' AND 3'X 60' USING 24" STONE ② THIS PERMIT SERVES AS NOTICE OF VIOLATION

Comments:/Conditions:

INITIAL SITE SKETCH

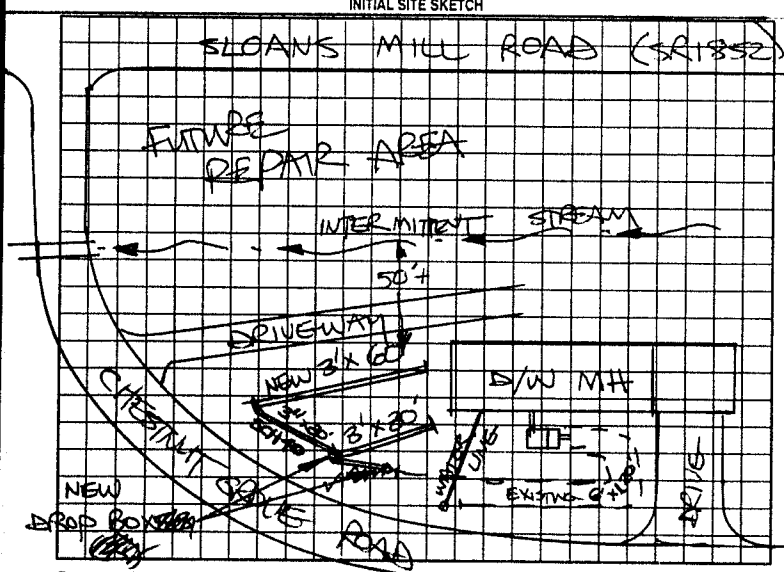

AS BUILT SKETCH

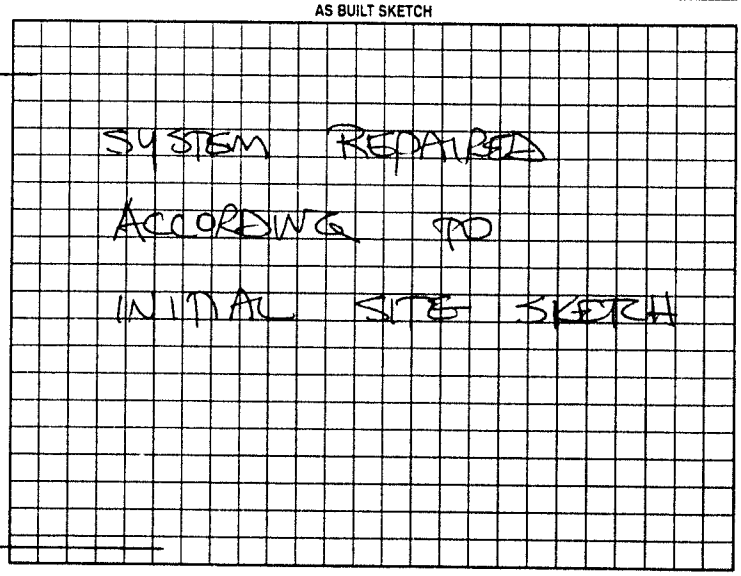

Permit can be suspended or revoked if any false information is supplied toward securing the permit/any unauthorized changes are made to the site/any unauthorized changes are made in the installation of the system. Improvement Permit with plat valid without expiration. Improvement Permit with site plan valid for sixty months. Authorization to Construct is valid for a period equal to that of Improvement Permit – not to exceed sixty months.

Signed: Marjorie Holloway date 2-5-00

Improvement Permit by: STEVE HEDRICK date 2-8-00

Authorization to Construct by: STEVE HEDRICK date 2-8-00

Installed by: TOMMY FRYE

Operation Permit by: STEVE HEDRICK date 2-9-00

Existing System Inspection by: date

HEALTH DEPT. COPY: WHITE OWNER COPY (FINAL): YELLOW OWNER COPY (INITIAL): PINK