IREDELL COUNTY HEALTH DEPARTMENT

STATESVILLE 704-878-5305 MOORESVILLE 704-664-5281

IMPROVEMENT PERMIT / CERTIFICATE OF COMPLETION / OPERATION PERMIT / EXISTING SYSTEM INSPECTION

PROPERTY DESCRIPTION NO. 67985 DATE 7-16-97 TAX MAP NO. 4843908245 Watershed: ☐ Yes ☐ No

OWNER OR CONTRACTOR Clark Ireland PHONE: Business _____ Home 539-4326

ADDRESS 1178 Sloans mill Rd Union Grove

LOCATION I-77 N TL 901 at Union Grove School TL Sloans Mills 1/2 mi corner Chestnut Oak Rd

SUBDIVISION _____ BLOCK / SECTION _____ LOT _____ LOT AREA 1.83 acres SITE CLASS. PS DESIGN FLOW 360 L.T.A.R. .3 gpl

Septic Tank: 1000 Gallons; STB 1017 Date 9-15-97

Pump Tank: _____ Gallons; PT _____ Date _____

Pump Make: _____ Model _____ Serial No. _____

Nitrification Field: No Fields 1 Square Feet 1200 Linear Feet 400

No Lines 3 Trench Width 36" Max Trench Bottom Depth 36" Gravel Depth 12"

☑ New System ☐ Repair System Type: I, II, III, IV, V, VI

System Description: Conv. Gravity

Repair System Description: Gravity Chambers

Maintenance Agreement Required: ☐ Yes ☑ No

☐ Slab ☐ Crawl Space ☐ Basement w/plumbing ☐ Basement wo/plumbing

☐ House/Mod. Home No. Bedrooms 3

☐ Mobile Home No. Bathrooms 2

☐ Business No. Employees _____


☐ Other _____

Water Supply:
☐ Individual
☐ Community
☑ Public

Comments:

77' 146'

INITIAL SITE SKETCH

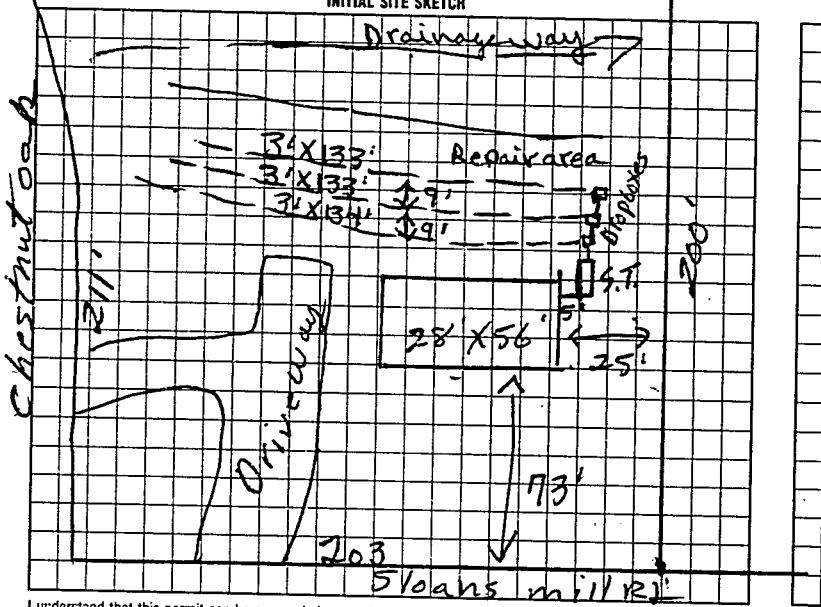

AS BUILT SKETCH

Same as initial Sketch

I understand that this permit can be suspended or revoked if any false information is supplied toward securing the permit/any unauthorized changes are made to the site/any unauthorized changes are made in the installation of the system. Improvement Permit is valid for 60 months from date of issuance.

Signed: X Clark Ireland

Improvement Permit by: L. C. moore date 7-16-97

Authorization to Existing System Inspection by: L. C. moore date 7-16-97

Authorization to count.

Installed by: Donald Lackey

Certificate of Completion by: _____ date _____

Operation Permit by: L. C. moore date 12-8-97

Authorization to count EXPIRES 60 mos from issue

HEALTH DEPT COPY: WHITE INSPECTION COPY (FINAL): GREEN OWNER COPY (FINAL): YELLOW INSPECTION COPY (INITIAL): PINK OWNER COPY (INITIAL): GOLD

S 9 E 1 0 0