IREDELL COUNTY HEALTH DEPARTMENT

Statesville Office (704) 878-5305 Mooresville Office (704) 660-3625 PERMIT # 202563

IMPROVEMENT PERMIT / AUTHORIZATION TO CONSTRUCT / OPERATION PERMIT / EXISTING SYSTEM

PIN # 4843910592

APPLICANT: Clark Ireland APPLICANT ADDRESS: 1196 Sloans Mill Rd Union Grove NC 28689

SITE ADDRESS: 1258 Sloans Mill Rd Union Grove NC 28689 PHONE: 704-437-0039 ALT. PHONE: 704-539-4269

SITE DIRECTIONS: N I-77 Exit 65 T/L then T/L on Sloans Mill Rd Lot on Left


SUBDIVISION: N/A SECTION: N/A LOT # N/A LOT AREA: 2.170ac DESIGN FLOW: 480 L.T.A.R.: .3

Septic Tank	1000 (gal)	STB	760	Date	10-2-14	[X] New System	[ ] Repair	[ ] Expansion	System Type: I II (III) IV V VI	[X] Residence	No. Bedrooms 4
Pump Tank	N/A (gal)	PT	N/A	Date	N/A	System Description:	25% Reduction			[ ] Business	No. Persons 8
Pump Make	N/A	Model	PolyLok	Serial #	PL-68	Repair System Description:	50% Reduction - Pump			[ ] Other	No. Employees
# Nitrification Fields	1	# Lines	4	Linear Ft:	400	Maintenance Agreement Required:	[ ] YES	[X] NO		[ ] Slab	[X] Crawl Space
Trench Width	36"	Max. Trench Bottom Depth	30"	Gravel Depth	N/A		[X] GRAVITY	[ ] PRESSURE		[ ] Basement w/plumbing	[ ] Basement w/o plumbing


Water Supply: [ ] Private [X] Public [ ] Community

Comments / Conditions: Install 25% reduction on contour with Serial distribution.

INITIAL SITE SKETCH

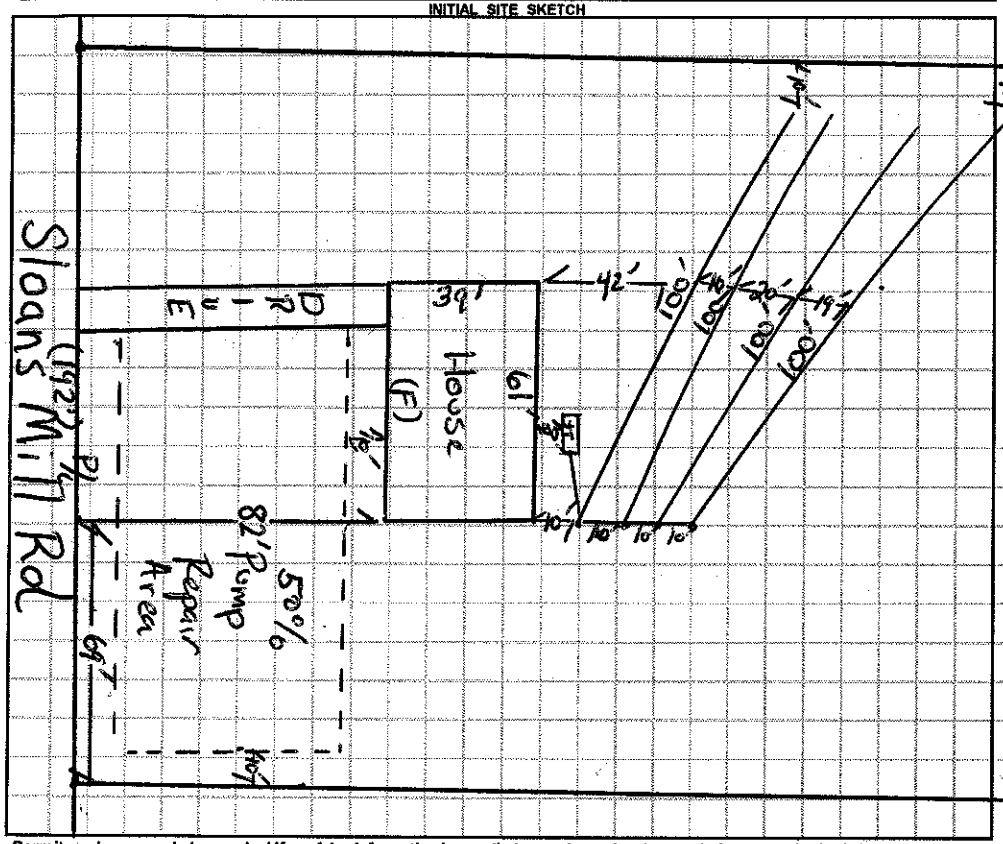

AS BUILT SKETCH

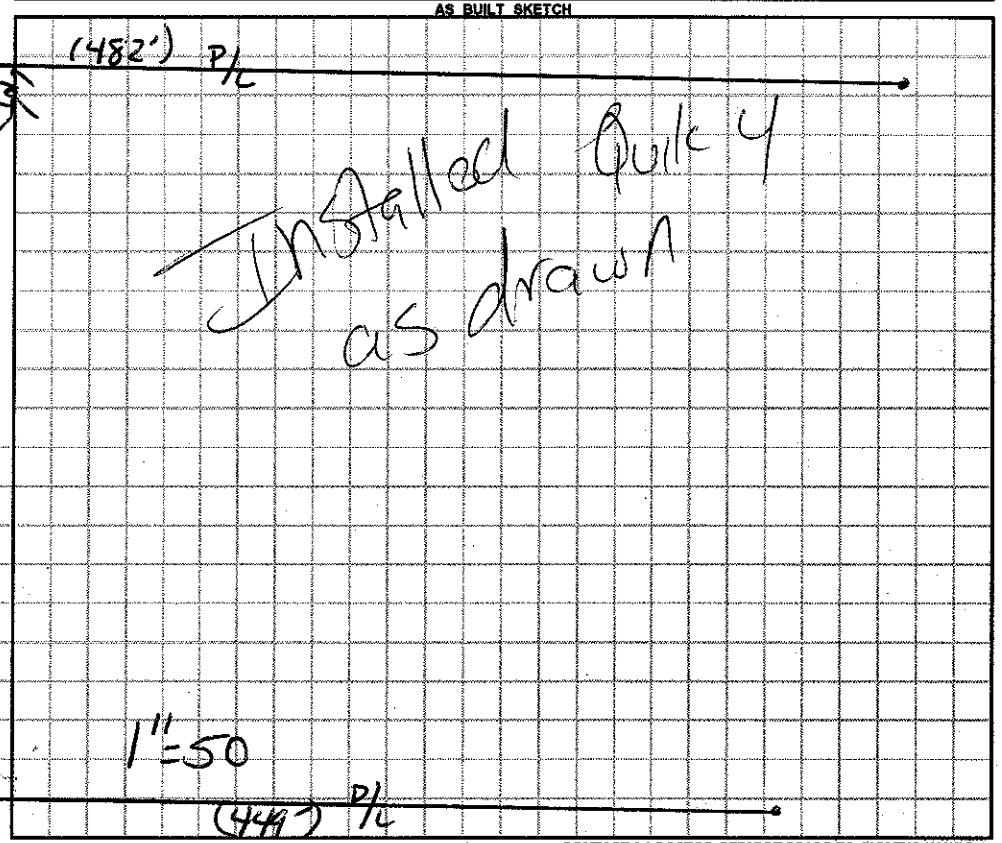

Permit can be suspended or revoked if any false information is supplied toward securing the permit / any unauthorized changes are made to the site / any unauthorized changes are made in the installation of the system. **CONTACT A LOCATOR SERVICE PRIOR TO ANY EXCAVATION**

[ ] **IMPROVEMENT PERMIT** *with plat valid without expiration.* [X] **IMPROVEMENT PERMIT** *with site plan valid for 60 mos.* [X] **AUTHORIZATION TO CONSTRUCT** *valid for period equal to IMPROVEMENT PERMIT--not to exceed 60 mo.*

Owner / Applicant Signature: Clark Ireland Date:

Installed by: Groundbreakers

IMPROVEMENT PERMIT by: Robert A. Lowe Date: 04/24/14

OPERATION PERMIT by: Robert A. Lowe Date: 03/23/15

AUTHORIZATION TO CONSTRUCT by: Robert A. Lowe Date: 04/24/14

Existing System Inspected by: Date:

Health Dept. Copy - WHITE Applicant (Final Approval) - YELLOW Applicant (Conditional Approval) - PINK