IREDELL COUNTY HEALTH DEPARTMENT

Statesville Office (704) 878-5305 Mooresville Office (704) 660-3625 PERMIT # 181194

IMPROVEMENT PERMIT / AUTHORIZATION TO CONSTRUCT / OPERATION PERMIT / EXISTING SYSTEM

PIN # 4843916063

APPLICANT: Colin Robinson APPLICANT ADDRESS: 137 Chestnut Oak Rd.

SITE ADDRESS: 137 Chestnut Oak Rd. PHONE: 704-539-4060 ALT. PHONE: N/A

SITE DIRECTIONS: I-77 N to exit # 65 TL US Hwy 901 TL Chestnut Oak Rd.

SUBDIVISION: N/A SECTION: N/A LOT # N/A LOT AREA: 1.12 acres DESIGN FLOW: 360gpd L.T.A.R.: 0.3

Septic Tank Existing (gal) STB N/A Date N/A
Pump Tank N/A (gal) PT N/A Date N/A
Pump Make N/A Model N/A Serial # N/A
Nitrification Fields 1 # Lines 4 Linear Ft: 260
Trench Width 36" Max. Trench Bottom Depth 36" Gravel Depth N/A


☐ New System ☑ Repair ☐ Expansion System Type: I II IIII IV V VI
System Description:
Repair System Description: 25% Reduction
Maintenance Agreement Required: ☐ YES ☑ NO
☐ GRAVITY ☐ PRESSURE

☑ Residence No. Bedrooms 3
☐ Business No. Persons
☐ Other No. Employees
☐ Slab ☑ Crawl Space
☐ Basement w/plumbing ☐ Basement w/o plumbing

Water Supply: ☑ Private ☑ Public ☐ Community

Comments / Conditions: Install a 25% Reduction system on contour with serial distribution. Replace septic tank if needed. Maintain 10' between new drainlines & water line, relocate water line if needed to maintain 10' setback. It is recommended that maple tree be removed from nitrification area. It is also recommended to remove mulch from over septic tank.

INITIAL SITE SKETCH

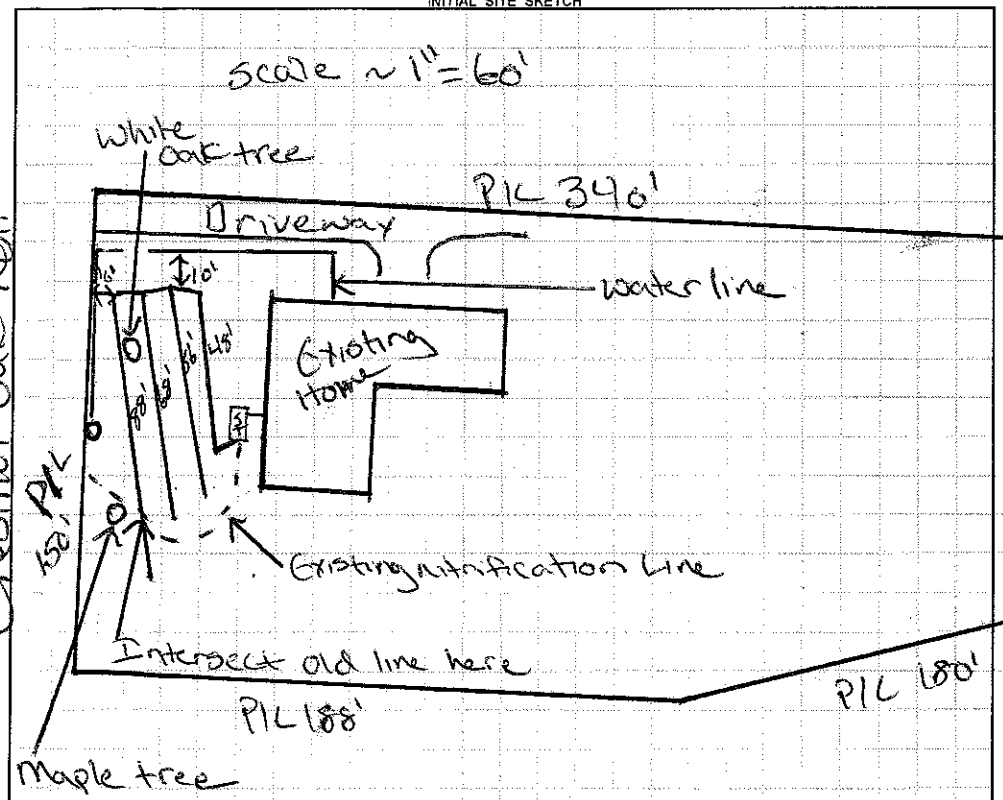

AS BUILT SKETCH

Quick 4 installed as drawn 03/05/14

Permit can be suspended or revoked if any false information is supplied toward securing the permit / any unauthorized changes are made to the site / any unauthorized changes are made in the installation of the system. **CONTACT A LOCATOR SERVICE PRIOR TO ANY EXCAVATION**

☐ **IMPROVEMENT PERMIT** *with plat* valid without expiration. ☑ **IMPROVEMENT PERMIT** *with site plan* valid for 60 mos. ☐ **AUTHORIZATION TO CONSTRUCT** valid for period equal to IMPROVEMENT PERMIT--not to exceed 60 mo.

Owner / Applicant Signature: Colin M Robinson Date: 10-10-13 Installed by: A-1 Backhoe

IMPROVEMENT PERMIT by: Justin Henderson Date: 10-7-13 OPERATION PERMIT by: Robert Shaw Date: 03/05/14

AUTHORIZATION TO CONSTRUCT by: Justin Henderson Date: 10-7-13 Existing System Inspected by: Date:

Health Dept. Copy - WHITE Applicant (Final Approval) - YELLOW Applicant (Conditional Approval) - PINK