IREDELL COUNTY HEALTH DEPARTMENT

STATESVILLE 704-878-5305 MOORESVILLE 704-664-5281 59268

IMPROVEMENT PERMIT / CERTIFICATE OF COMPLETION / OPERATION PERMIT / EXISTING SYSTEM INSPECTION

PROPERTY DESCRIPTION NO. 23066 DATE 2-9-96 TAX MAP NO 16H-3-A-16 Watershed: Yes / No

OWNER OR CONTRACTOR BRAD KOEPNICK PHONE Business Home 592-5493

ADDRESS P.O. BOX 5574, STATESVILLE NC 28687

LOCATION I-77N, TL NC901, TL CHESTNUT OAK ROAD, 4TH MH ON RIGHT

SUBDIVISION WOOTEN BLOCK / SECTION LOT LOT AREA LIMITED SITE CLASS PS DESIGN FLOW 240 L T A R EXISTING

Septic Tank: EXISTING Gallons, STB Date

Pump Tank: Gallons, PT Date

Pump Make: Model Serial No

Nitrification Field: No Fields Square Feet Linear Feet EXISTING

No Lines Trench Width Max Trench Bottom Depth Gravel Depth

New System Repair System Type CONV. GRAVITY

System Description

Repair System Description

Maintenance Agreement Required Yes / No

Slab / Crawl Space Basement w/plumbing Basement wo/plumbing

/ House/Mod Home No Bedrooms 2

Mobile Home No Bathrooms 1

Business No Employees

Other


Water Supply: / Individual Community Public WELL

Comments:

Comments SYSTEM SIZED FOR 2 BEDROOM ONLY
KEEP MH MINIMUM 5' FROM SYSTEM

INITIAL SITE SKETCH

AS BUILT SKETCH

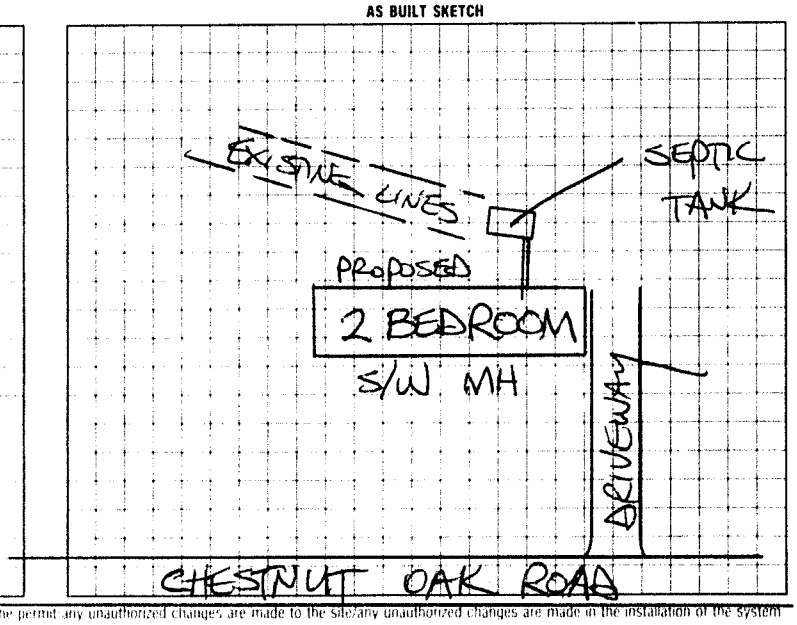

I understand that this permit can be suspended or revoked if any false information is supplied toward securing the permit, any unauthorized changes are made to the site, any unauthorized changes are made in the installation of the system

Signed

Improvement Permit by date

Existing System Inspection by STEVE HEDRICK date 2/9/96

Installed by

Certificate of Completion by date

Operation Permit by date

HEALTH DEPT COPY WHITE INSPECTION COPY (FINAL) GREEN OWNER COPY (FINAL) YELLOW INSPECTION COPY (INITIAL) PINK OWNER COPY (INITIAL) GOLD