IREDELL COUNTY HEALTH DEPARTMENT

Statesville Phone TR 3-7271 Mooresville Phone NO 3-1271

PERMIT TO INSTALL SEPTIC TANK

Permit NO. _____ Permit Date 4-5- 1966

Owner Union Grove Fire Dept. Address _____

Installed By Sonny Reavis Address Harmony N.C.


Location of Property Hwy 21 N L. 901

| Tank | | Capacit | | Length of Lines | | Fixtures | |
|---|---|---|---|---|---|---|---|
| Block | ( ) | ~~1000~~ | ( ) | 225' | ( ) | No. of Baths | ( ) |
| Precast | ( ) | 1250 | ( ) | 250' | ( ) | Bishwasher | ( ) |
| | | 1500 | ( ) | Other _____ | | Garbage Grdr. | ( ) |
| | | Other _____ | | | | Other _____ | |

NOTIFY HEALTH DEPARTMENT AT LEAST EIGHT HOURS BEFORE TANK IS TO BE INSPECTED.

Final Inspection 4-5 1966 Approved (✓) Disapproved ( )

Remarks [redacted]

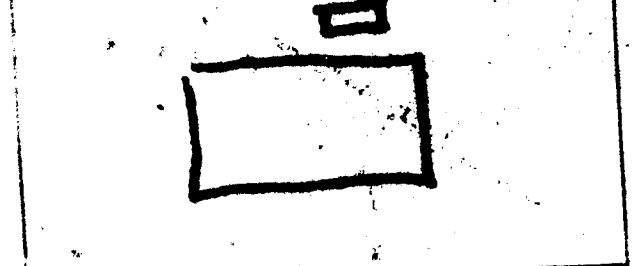

Sketch of Installation

Andrew D. Hutchens
Sanitarian

RS