IREDELL COUNTY HEALTH DEPARTMENT

STATESVILLE 704-878-5305 MOORESVILLE 704-664-5281

IMPROVEMENT PERMIT / AUTHORIZATION TO CONSTRUCT / OPERATION PERMIT / EXISTING SYSTEM INSPECTION

PERMIT# REPAIR PIN# 4843-93-6222 DATE MAR 18, 08

OWNER OR APPLICANT DENNIS L. & AMANTHA GILREATH PHONE: Business _____ Home 704-539-4430

ADDRESS 458 INDIAN HILL ROAD, OLIN NC 28660

LOCATION I-77 N, TL NC 901, TR UNION GROVE ROAD, 1ST HOUSE ON RIGHT AT #1445

SUBDIVISION _____ BLOCK / SECTION _____ LOT _____ LOT AREA 0.8 ACRE SITE CLASS. PS DESIGN FLOW 360 L.T.A.R. 0.30 GPD/FT²

Septic Tank: 1000 Gallons; STB 760 Date 3-30-08
Pump Tank: _____ Gallons; PT _____ Date _____
Pump Make: _____ Model _____ Serial No. _____
Nitrification Field: No. Fields 1 Square Feet EQ TO 1200 Linear Feet 300
No. Lines THREE Trench Width 36" Max Trench Bottom Depth (30") Gravel Depth N/A

☐ New System ☑ Repair ☐ Expansion System Type: I II (III) IV V VI
System Description: _____
Repair System Description: 25% REDUCTION, GRAVITY
Maintenance Agreement Required: ☑ Yes ☐ No

☑ House/Mod. Home No. Bedrooms 3
☐ Mobile Home No. Persons ____
☐ Business No. Employees ____
☐ Other _____


Water Supply: ☐ Individual ☑ Public ☐ Community

☐ Slab ☑ Crawl Space ☐ Basement w/plumbing ☐ Basement wo/plumbing


Comments:/Conditions: (1) INSTALL NEW SEPTIC TANK AT LOCATION SHOWN (2) INSTALL NEW 25% REDUCTION SYSTEM ON CONTOUR AS SHOWN, (3) CRUSH AND FILL EXISTING SEPTIC TANK

Comments:/Conditions: SYSTEM TO BE REPAIR BY 3-31-08
SEPTIC TANK WITH MARKER INSTALLED USING RED "POLYLOK" RISER

INITIAL SITE SKETCH

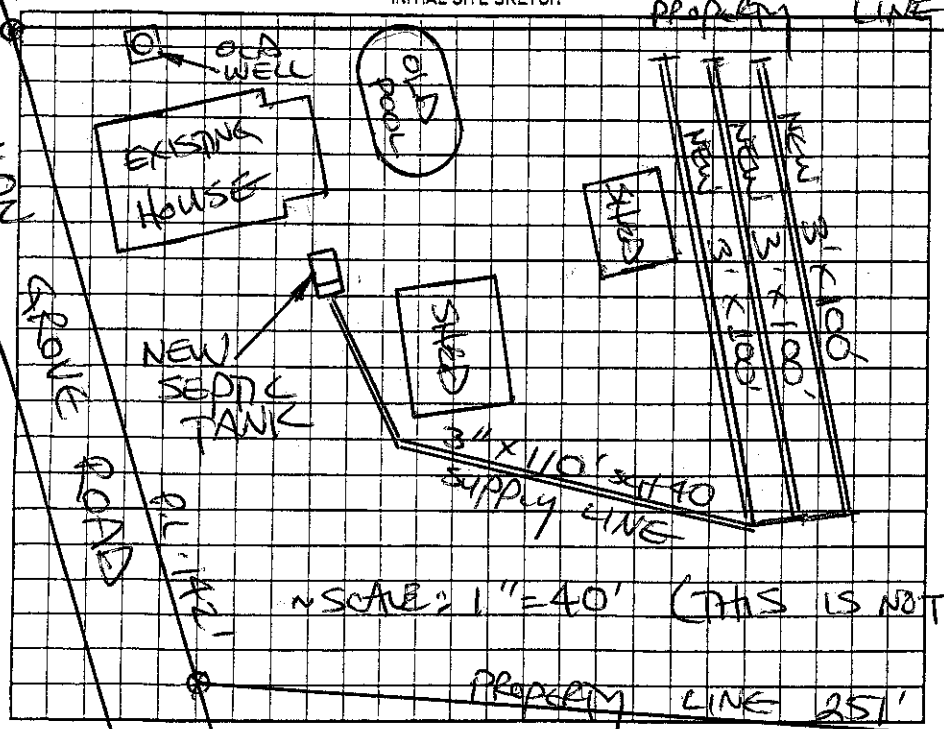

AS BUILT SKETCH

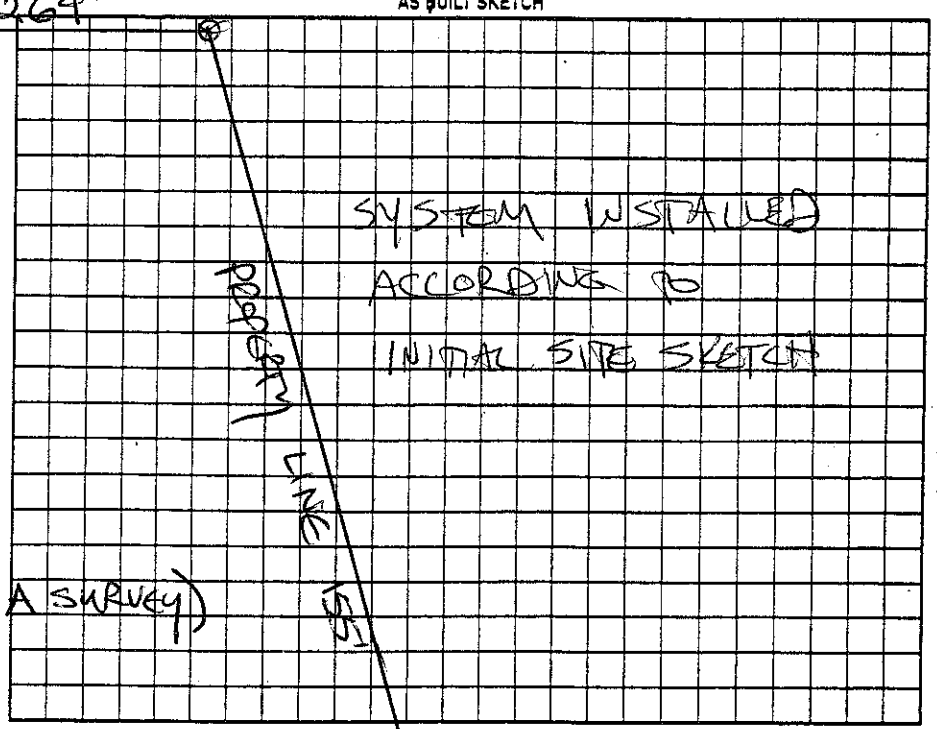

Permit can be suspended or revoked if any false information is supplied toward securing the permit/any unauthorized changes are made to the site/any unauthorized changes are made in the installation of the system. Improvement Permit with plat valid without expiration ☐ Improvement Permit with site plan valid for sixty months ☑ Authorization to Construct is valid for a period equal to that of Improvement Permit – not to exceed sixty months.

Signed: Dennis Gilreath date 3-18-08 Installed by: A-1 BACKHOE

Improvement Permit by: STEVE HEDRICK date 3-18-08 Operation Permit by: STEVE HEDRICK date 6-10-08

Authorization to Construct by: STEVE HEDRICK date 3-18-08 Existing System Inspection by: _____ date _____

HEALTH DEPT. COPY: WHITE OWNER COPY (FINAL): YELLOW OWNER COPY (INITIAL): PINK